



**ADDENDUM NO. 1**  
**2026 Citywide Preventative Bridge Maintenance**  
**PWE NO. BR2501**

Addendum No. 1 to the Plans, Specifications and Contract documents is hereby submitted via email for use in bid preparations and submittal.

The following changes, additions, and/or deletions are hereby made a part of the **2026 Citywide Preventative Bridge Maintenance Project**, dated March 23, 2026, as fully and completely as if the same were entirely set forth in the Plans, Specifications, and Contract documents. Changes and additions are noted in *highlighted italics*, and deletions are noted in ~~strike through~~. **The Bid opening date of April 9, 2026, at 1:30 p.m. remains unchanged.**

Changes are as follows:

**BIDDER'S PACKET**

**The Bid Proposal Form has been modified as follows:**

Bid Item Quantities that have been modified:

<b>BID ITEM NO.</b>	<b>DESCRIPTION</b>	<b>UNIT</b>	<b>ORIGINAL BID QUANTITY</b>	<b>MODIFIED BID QUANTITY</b>
5	REMOVING CEMENT CONC. CURB	LF	<del>109</del>	<i>49</i>
7	CATCHBASIN TYPE 1	EA	<del>3</del>	<i>1</i>
25	HMA CL. 3/8 IN. PG64S-28	TON	<del>44</del>	<i>43</i>
34	PLASTIC LINE	LF	<del>1349</del>	<i>1132</i>
41	MANHOLE FRAME AND LID	EA	<del>2</del>	<i>1</i>
42	WATER VALVE BOX	EA	<del>5</del>	<i>3</i>
44	CEMENT CONC. TRAFFIC CURB AND GUTTER	LF	<del>101</del>	<i>41</i>



Bid Items that have been deleted:

BID ITEM NO.	WSDOT SPEC	ESTIMATED QUANTITY	DESCRIPTION	UNITS
33	8-20	65	CONDUIT PIPE 2 IN. DIAM.	LF
35	8-22	169	PLASTIC WIDE LINE	LF
36	8-22	140	PLASTIC CROSSWALK LINE	SF
37	8-22	1	PLASTIC BICYCLE LANE SYMBOL	EA
49	8-15	2	CEMENT CONC. CURB RAMP TYPE – PARALLEL	EA

**PLANS**

**The Project Plans have been modified as follows:**

Plan Sheet IN3 – General Notes and Summary of Quantities:

*Summary of Quantities Table*

Bid item quantities have been modified for the Three Mille Bridge. Revisions shown on the addendum plan sheets are clouded and shown in **Bold** text.

*Plan Sheet B05 – Three Mile Road Layout (Tausick Way)*

*Plan View*

The Plan View has been modified in the following ways:

*Removals*

*65 lf of Conduit Pipe 2 In. Diam.*

*169 lf of Plastic Wide Line*

*140 sf of Plastic Crosswalk Line*

*1 Plastic Bicycle Lane Symbol*

*2 Cement Conc. Curb Ramp Type – Parallel*

*2 HMA path approaches to cement conc. curb ramps*



*2 Water Valve Boxes*

*1 Manhole Frame and Lid*

*Modification:*

*HMA Transitions have been reduced from 30 lf to 5 lf as measured along the centerline of the roadway*

*Plastic Line has been reduced*

Notice is hereby given that this addendum must be acknowledged on the proposal (above the signature line on the Non-Collusion Declaration page) for the **2026 Citywide Preventative Bridge Maintenance Project**, as evidence that the bidder is familiar with all changes incorporated herein.

Submitted by:

Elaine Dawson  
Project Coordinator

## SUBMIT BID USING THIS SPREADSHEET

Bidder shall use this version of the official Proposal bid form provided with Addendum No. 1 to replace the original bid form. It is the bidder's responsibility to ensure the accuracy of bid item totals.

### SCHEDULE A - GENERAL

Item No.	WSDOT Spec.	Estimated Quantity	Description	Unit Price	Units	Total Amount
			<b>Section: 1 Preparation</b>			
1	1-09	1	Mobilization		LS	
2	1-07	1	Archaeological And Historical Salvage	\$10,000.00	EST	\$10,000.00
3	2-02*	59	Removing Reinforced Cement Conc. Sidewalk		SY	
4	2-02	271	Removing Cement Conc. Sidewalk		SY	
5	2-02	<del>49</del> 109	Removing Cement Conc. Curb		LF	
6	8-22	1238	Removing Plastic Line		LF	
			<b>Section: 5 Storm Sewer</b>			
7	7-05	<del>1</del> 3	Catchbasin Type 1		EA	
			<b>Section: 8 Structure</b>			
8	5-04	22	Waterproof Membrane Br. No.		SY	
9	5-07	547	Planing Bituminous Pavement		SY	
10	6-02	232	Expansion Joint System Compression Seal - Superstructure		LF	
11	6-02	5	Epoxy Resin		GAL	
12	6-02	68	Epoxy Crack Sealing		LF	
13	6-02*	1	Force Account Epoxy Crack Sealing Cores	\$3,000	EST	\$3,000.00
14	6-02*	2375	Pigmented Sealer for Concrete Surfaces		SF	
15	6-09	805	Further Deck Preparation for Type 1 Deck Repair		SF	
16	6-09	415	Further Deck Preparation for Type 2 Deck Repair		SF	
17	6-09*	1	Force Account Reinforcing Steel	\$2,000	EST	\$2,000.00
18	6-09*	1656	Polyester Concrete Overlay		SY	
19	6-23*	440	Remove Concrete and Coat Reinforcing Steel		SF	
20	6-23*	94	Repair Bridge Rail and Sidewalks		CF	
21	6-23*	41	Repair Bridge Substructure		CF	
22	6-23*	27	Repair Bridge Girders		CF	
23	6-23*	84	Reconstruct Concrete Beam		CF	


24	6-24	1037	Silane Sealer		SY	
			<b>Section: 14 Hot Mix Asphalt</b>			
25	5-04	<b>43</b> <del>44</del>	HMA Cl. 3/8 In. PG64S-28		TON	
26	5-05	1	Job Mix Compliance Price Adjustment	-\$1.00	CALC	-\$1.00
27	5-06	1	Compaction Price Adjustment	-\$1.00	CALC	-\$1.00
			<b>Section: 17 Erosion Control and Roadside Planting</b>			
28	1-07	1	SPCC Plan		LS	
29	8-01	18	ESC Lead		DAY	
30	8-01	25	Inlet Protection		EA	
31	8-01	1	Erosion Control and Water Pollution Prevention		LS	
			<b>Section: 18 Traffic</b>			
32	1-10	6	Project Temporary Traffic Control		LS	
<del>33</del>	<del>8-20</del>	<del>65</del>	<del>Conduit Pipe 2 In. Diam.</del>	<del>————</del>	<del>LF</del>	<del>————</del>
34	8-22	<b>1132</b> <del>1349</del>	Plastic Line		LF	
<del>35</del>	<del>8-22</del>	<del>169</del>	<del>Plastic Wide Line</del>	<del>————</del>	<del>LF</del>	<del>————</del>
<del>36</del>	<del>8-22</del>	<del>140</del>	<del>Plastic Crosswalk Line</del>	<del>————</del>	<del>SF</del>	<del>————</del>
<del>37</del>	<del>8-22</del>	<del>1</del>	<del>Plastic Bicycle Lane Symbol</del>	<del>————</del>	<del>EA</del>	<del>————</del>
			<b>Section: 19 Other Items</b>			
38	1-04	1	Minor Change	\$25,000.00	CALC	\$25,000.00
39	1-05	1	ADA Feature Surveying		LS	
40	1-05*	1	Record Drawings (\$3000.00 Minimum)		LS	
41	7-05*	<b>1</b> <del>2</del>	Manhole Frame and Lid		EA	
42	7-12*	<b>3</b> <del>5</del>	Water Valve Box		EA	
43	8-14	274	Cement Conc. Sidewalk		SY	
44	8-14	<b>41</b> <del>101</del>	Cement Conc. Traffic Curb and Gutter		LF	
45	8-14	8	Cement Conc. Pedestrian Curb		LF	
46	8-14*	59	Reinforced Conc. Sidewalk		SY	
47	8-14*	103	Grind Sidewalk		LF	
48	8-14*	260	Cement Conc. Pavers		SF	
<del>49</del>	<del>8-15</del>	<del>2</del>	<del>Cement Conc. Curb Ramp Type Parallel</del>	<del>————</del>	<del>EA</del>	<del>————</del>

\*Non-Standard, Special Provision Pay Item


<b>Schedule A Subtotal</b>	
<b>No Sales Tax on Schedule A</b>	\$0.00
<b>BASE BID TOTAL (SCHEDULE A)</b>	




Plot Date: 3/18/2026 1:42 PM  
 Save Date: 3/18/2026 1:40 PM  
 By: Brennan\_Herron  
 File: P:\WALLA\000000120400\CAD\SHEET\Three Mile\WALLA12\_S\_L\_ThreeMile.dwg

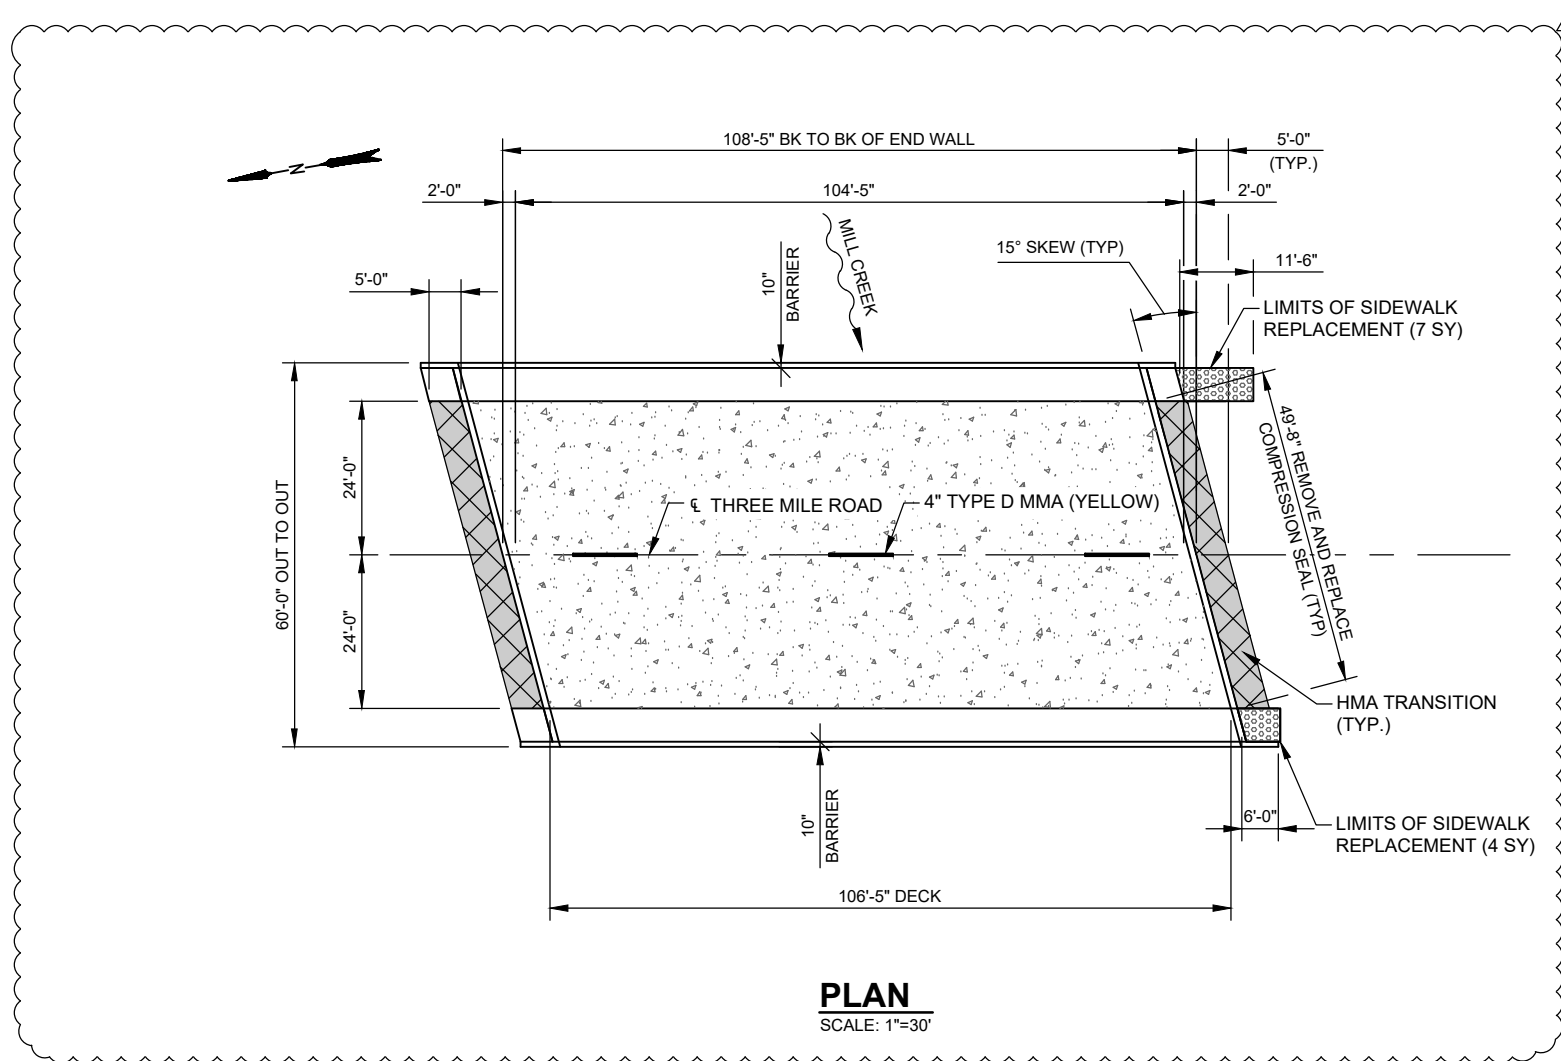

**PLAN**  
SCALE: 1"=30'

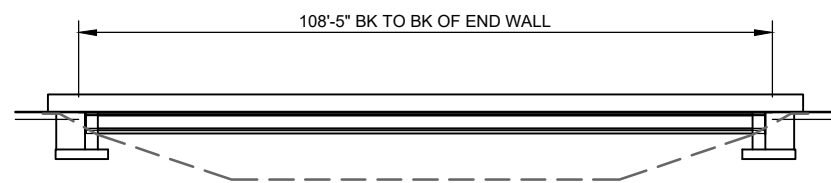

**SECTION**  
SCALE: 1"=30'

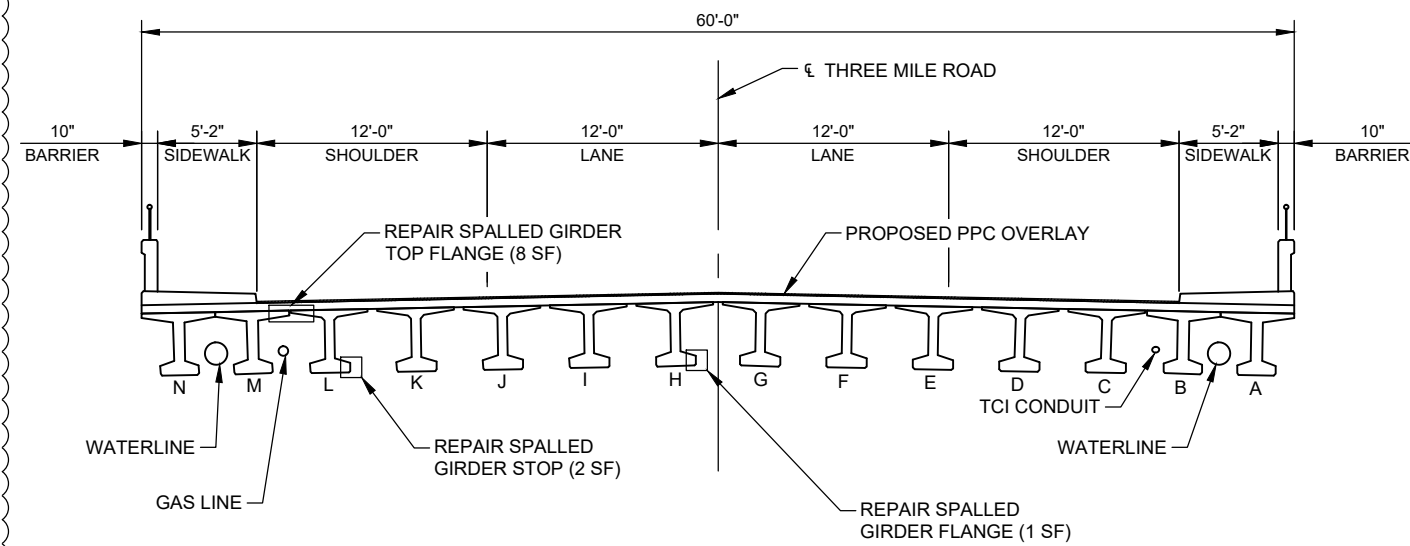

**TYPICAL SECTION**  
SCALE: 1"=10'

**WORK DESCRIPTION**

1. PARTIAL DEPTH BRIDGE DECK REPAIR (5% DECK AREA 255 SF)
2. REPAIR CONCRETE GIRDER STOP AND FLANGES
3. APPLY PPC OVERLAY
4. REPLACE COMPRESSION SEAL
5. REPLACE DAMAGED SIDEWALK PANEL
6. PAVEMENT MARKINGS

**LEGEND**

- LIMITS OF DECK SOUNDING AND DECK REPAIR, AND POLYESTER POLYMER CONCRETE OVERLAY
- LIMITS OF SIDEWALK REPLACEMENT
- LIMITS OF HMA
- LIMITS OF ASPHALT APPROACH GRINDING



DESIGNED BY: J. LEMASTER		BY: JL		CK: JW	
DETAILED BY: B. HERRON					
CHECKED BY: J. WARREN					
NO.	DATE	REVISION	BY	CK	
1	3/26/26	REVISED APPROACHES AND STRIPING	JL	JW	



<b>CITYWIDE PREVENTATIVE BRIDGE MAINTENANCE</b> FEDERAL-AID NO. BHM-9936(007)	
<b>THREE MILE ROAD LAYOUT</b> <b>(TAUSICK WAY)</b>	
CITY OF WALLA WALLA	WASHINGTON
PROJECT NO. <b>BR-2501</b>	SHEET NO. <b>08</b> OF <b>34</b>
<b>B05</b>	