



APPENDIX A:
Existing Bridge As-built Plans

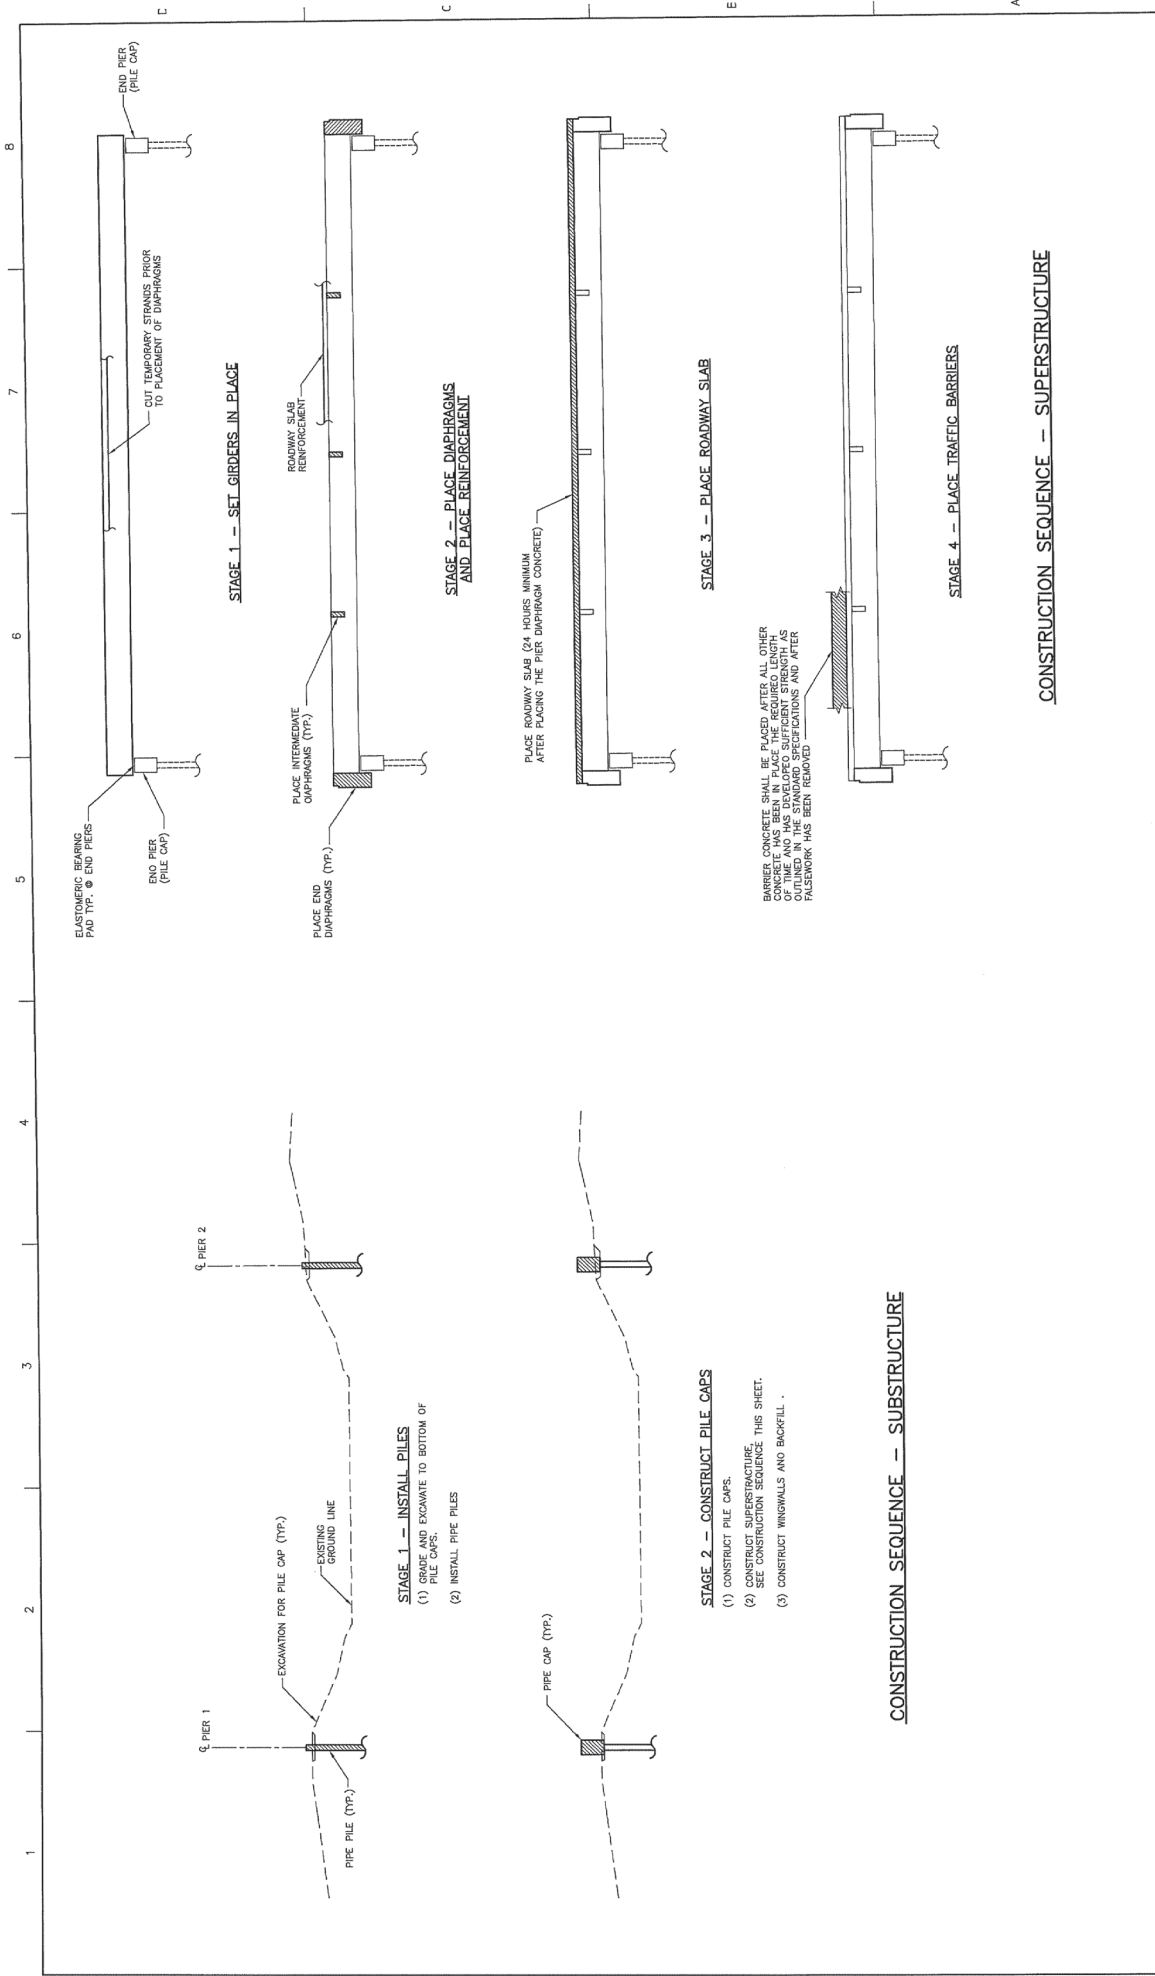

CONSTRUCTION SEQUENCE — SUBSTRUCTURE

CONSTRUCTION SEQUENCE — SUPERSTRUCTURE

MYRA ROAD EXTENSION PROJECT MYRA ROAD MILL CREEK BRIDGE CONSTRUCTION SEQUENCE				
PROJECT MANAGER: MICHAEL A. MURRAY DESIGNED BY: BRETT T. ARKSSON PATRICK T. LI DRAWN BY: LARRY O. KELLER			FILE NAME: DOB-02.dwg SCALE: NO SCALE	
PROJECT NUMBER: 22315			SHEET: B-02	

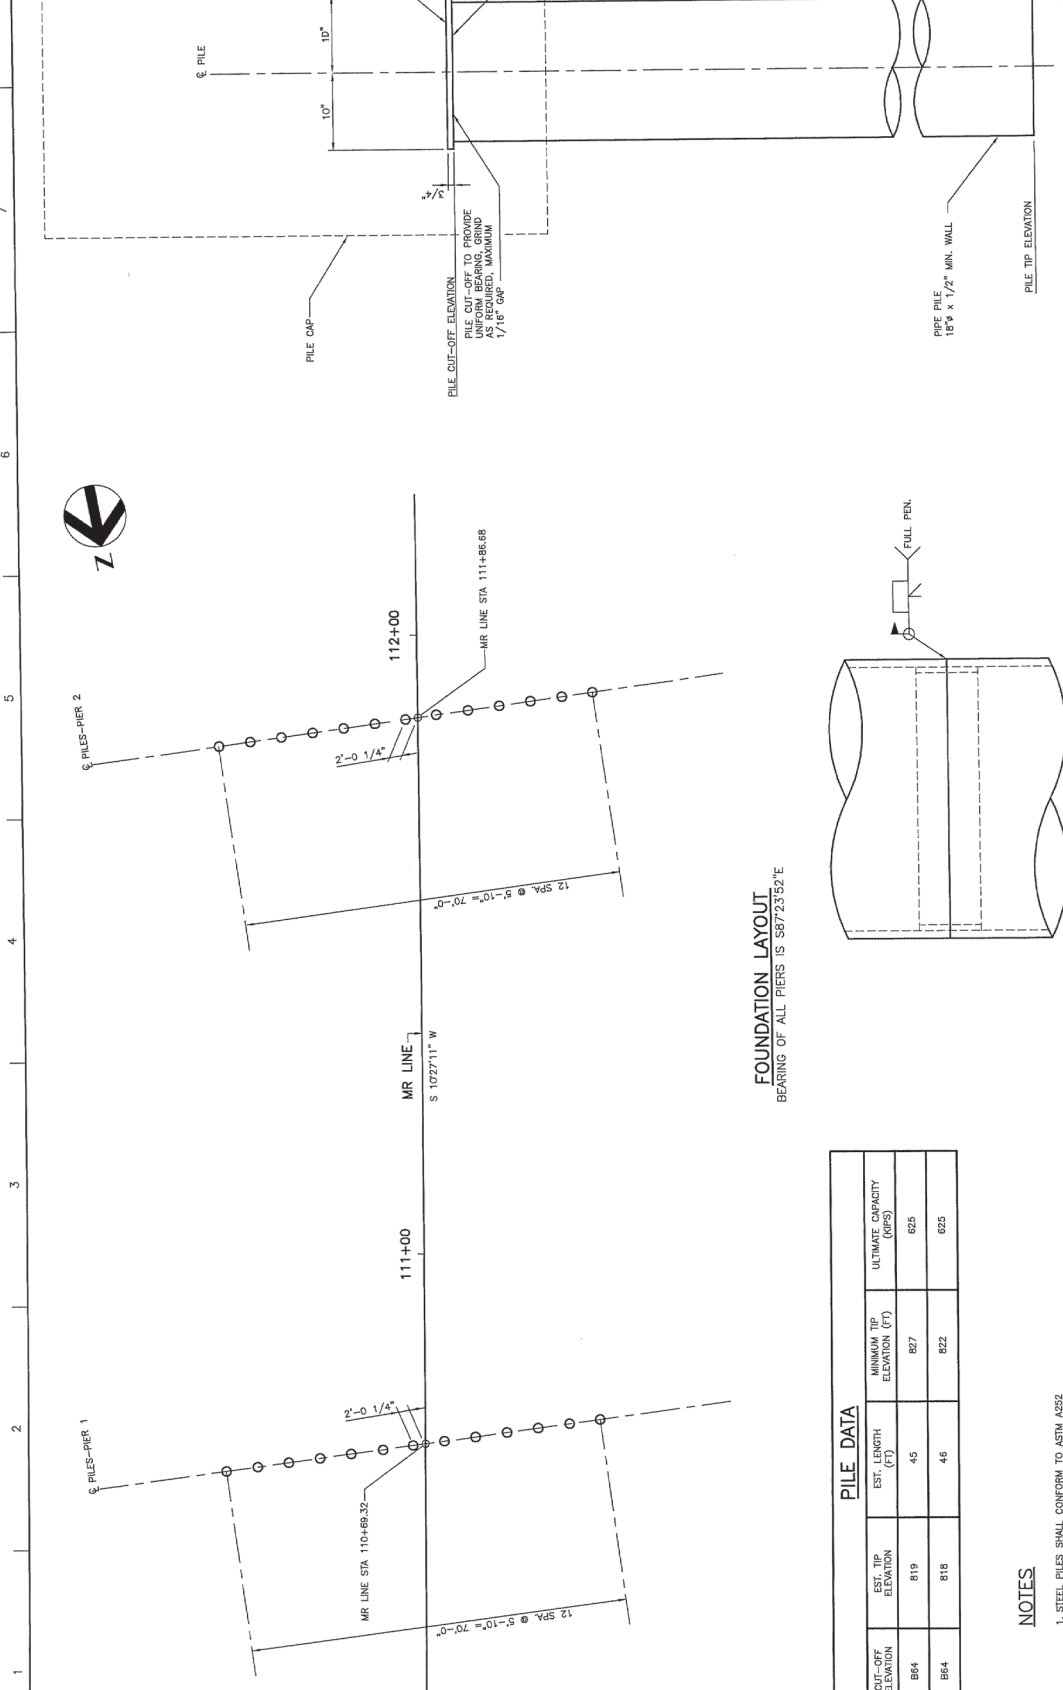


PIER	CUT-OFF ELEVATION	EST. TIP ELEVATION	EST. LENGTH (FT)	MINIMUM TIP ELEVATION (FT)	ULTIMATE CAPACITY (KIPS)
1	864	819	45	827	625
2	864	816	46	822	625


NOTES

- STEEL PILES SHALL CONFORM TO ASTM A252 GRADE 2.
- STEEL PILES SHALL BE DRIVEN CLOSED END AND HAVE PROTECTIVE IRP.
- INSTALL PILES AND DRIVERS PRIOR TO CONSTRUCTING RETAINING WALL BACKFILL.

PILE SPICE DETAIL

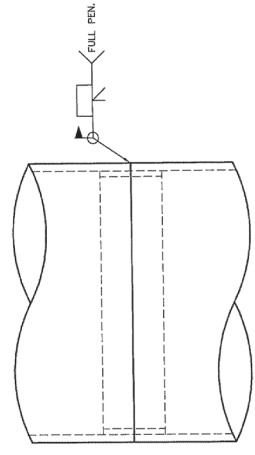

PILE ELEVATION


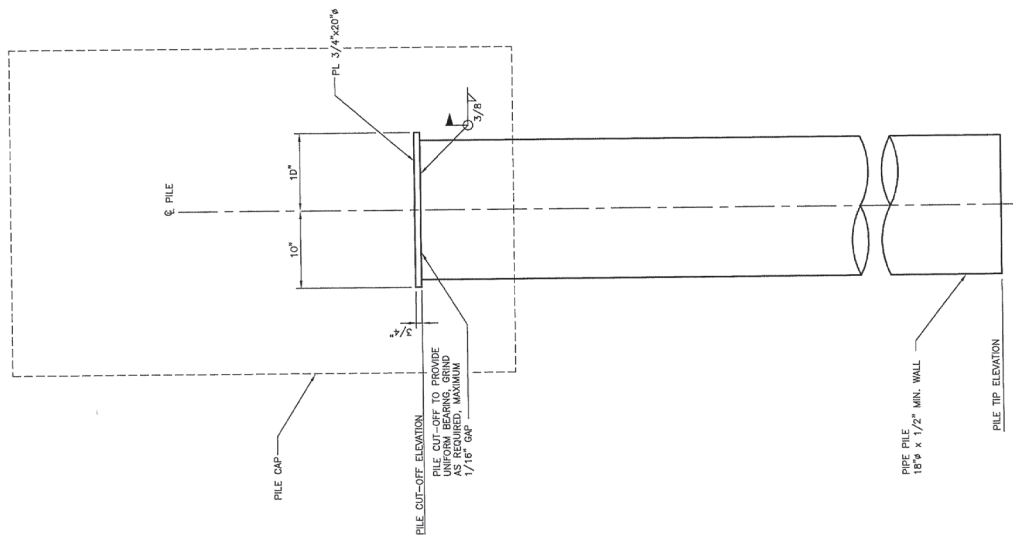


FOUNDATION LAYOUT
BEARING OF ALL PIERS IS S67°23'52"E



ISSUE	DATE	DESCRIPTION


PROJECT MANAGER: MICHAEL A. MURRAY
DESIGNED BY: BRETT T. AKSESSON
DRAWN BY: LARRY D. KELLER
PROJECT NUMBER: 22315

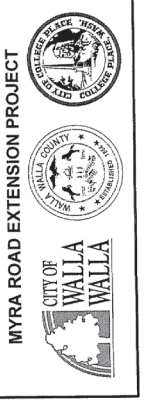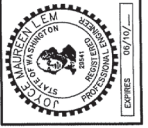

MYRA ROAD
MILL CREEK BRIDGE
FOUNDATION PLAN

FILENAME: 008-03.dwg
SCALE: NO SCALE

SHEET: B-03

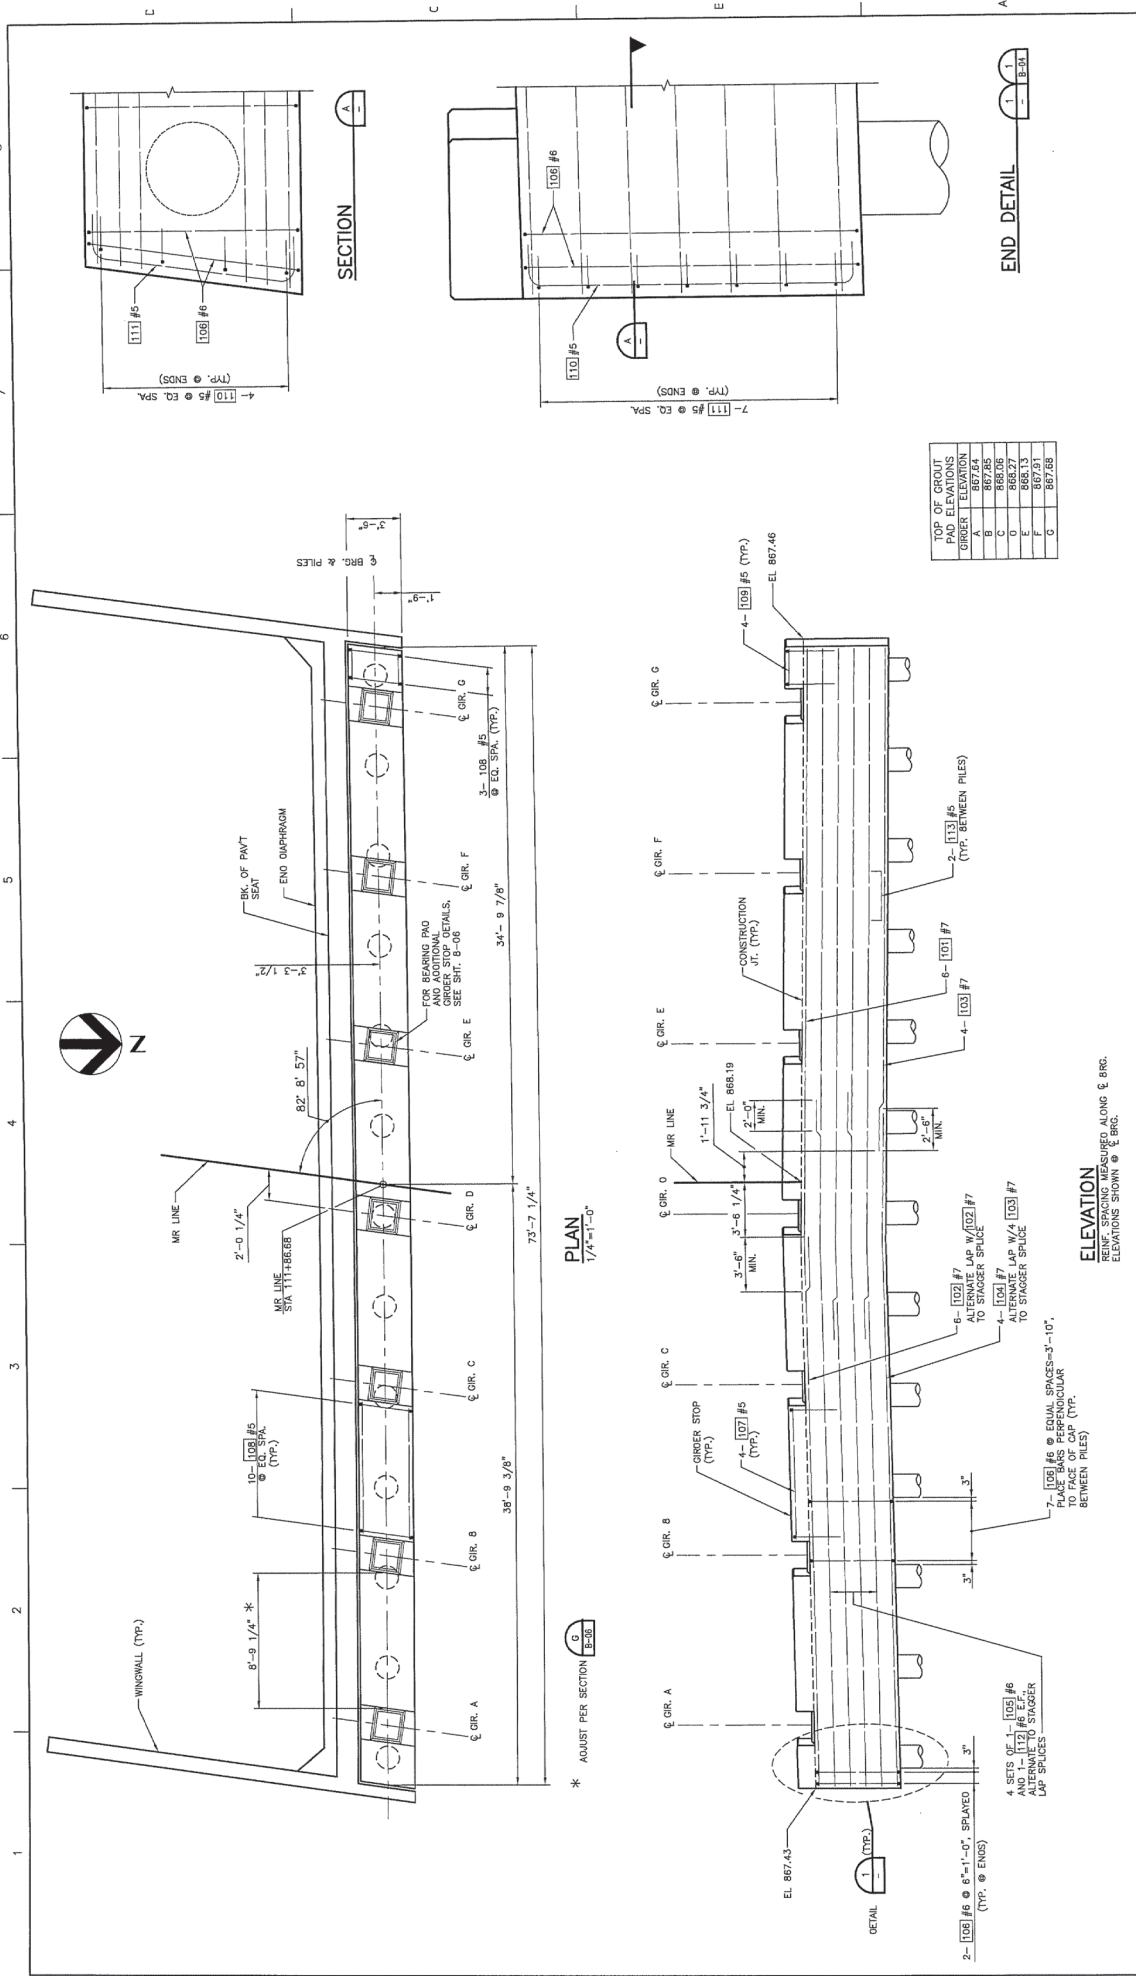

USKH
ARCHITECTURE • ENGINEERING
LAND SURVEYING • PLANNING

HDR
HDR Engineering Inc.

MYRA ROAD EXTENSION PROJECT

CITY OF WALLA WALLA

WALLA WALLA COUNTY
WALLA WALLA
WALLA WALLA

PROJECT MANAGER: MICHAEL A. MURRAY
DESIGNED BY: BRETT T. AKSSON
DRAWN BY: LARRY O. KELLER


PROJECT NUMBER: 22315
ISSUE DATE DESCRIPTION

MYRA ROAD
MILL CREEK BRIDGE
PIER 2 - PLAN AND ELEVATION

FILENAME: 1005-05.dwg
SCALE: NO SCALE
SHEET: B-05



1 2 3 4 5 6 7 8

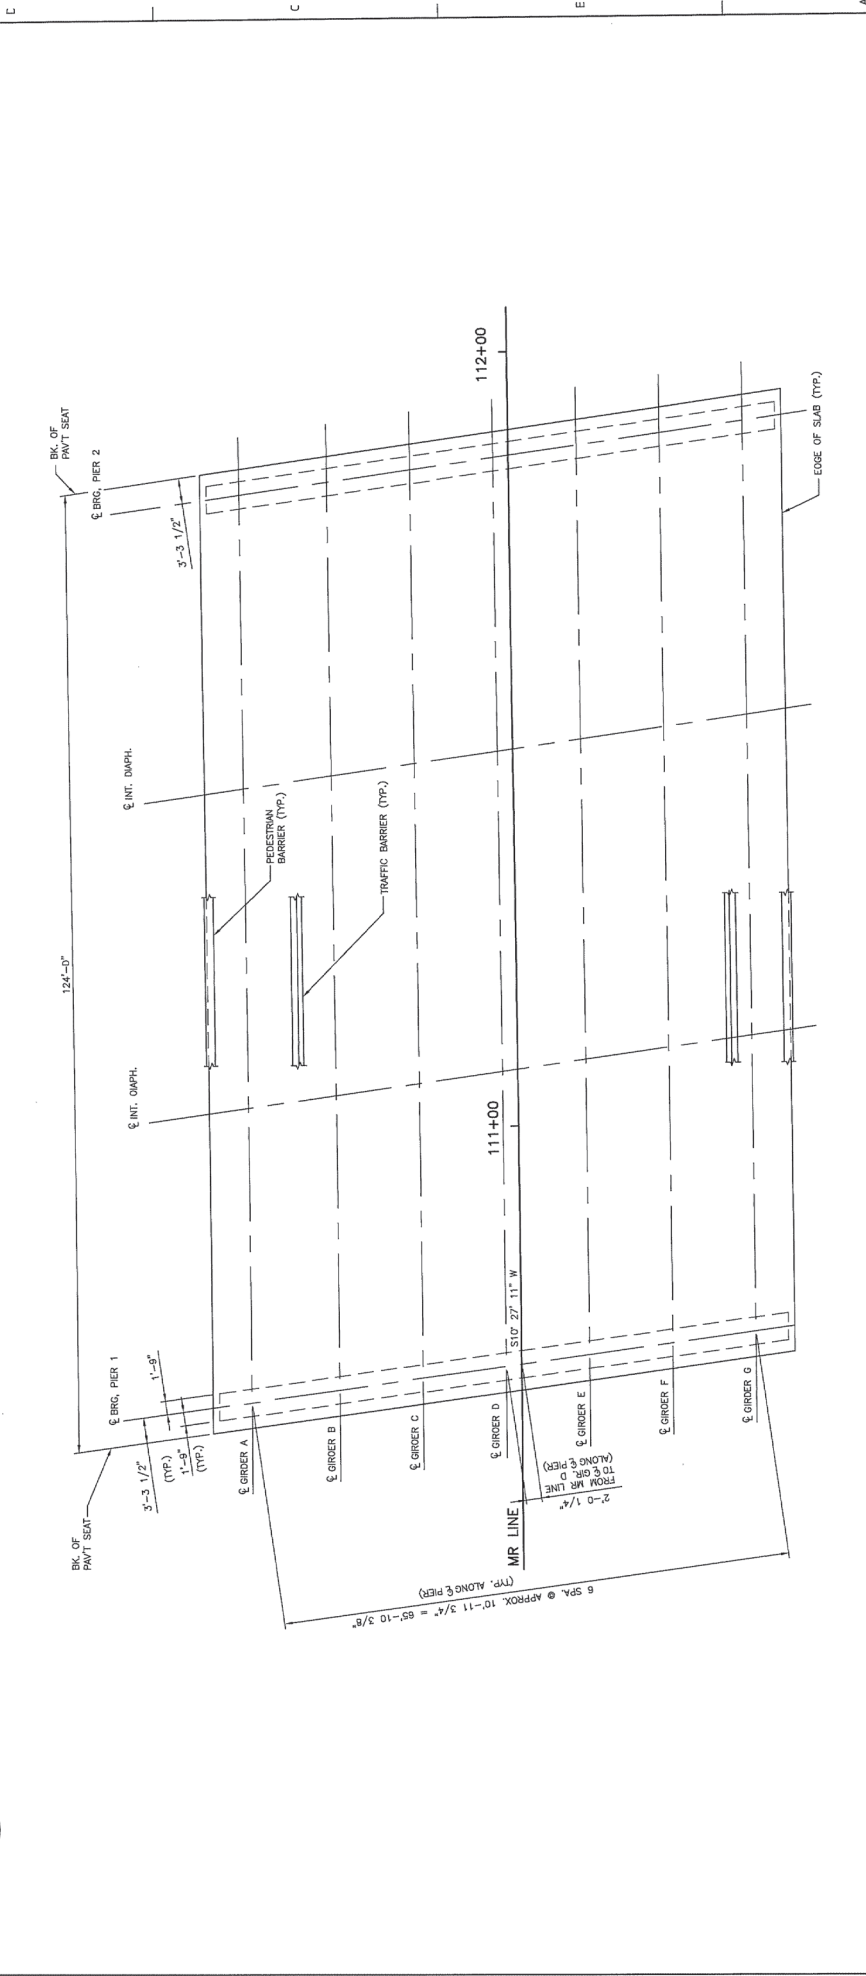


FRAMING PLAN
 BEARING OF ALL IS S87°23'52" E



ISSUE	DATE	DESCRIPTION

PROJECT MANAGER: MICHAEL A. MURRAY
DESIGNED BY: BRETT T. AKESSON
DRAWN BY: LARRY O. KELLER
PROJECT NUMBER: 22315

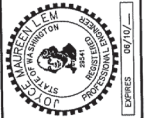

MYRA ROAD EXTENSION PROJECT

CITY OF WALLA WALLA

WALLA WALLA COUNTY


WALLA WALLA WATER RECLAMATION DISTRICT

MYRA ROAD MILL CREEK BRIDGE FRAMING PLAN

FILENAME: I02P-07.dwg
 SCALE: NO SCALE
 SHEET: B-07

NOTES:


- ALL DETAILS ON THIS SHEET ARE FOR PRETENSIONED DESIGN ONLY.
- PLAN LENGTH SHALL BE INCREASED AS NECESSARY TO COMPENSATE FOR SHORTENING DUE TO PRESTRESS AND SHRINKAGE.
- EXTRA CAUTION MUST BE EXERCISED IN HANDLING AND PLACING GIRDERS. ALL GIRDERS SHALL BE CHECKED FOR TIPPING AND TO CONTROL LATERAL BENDING DURING SHIPMENT. ONCE ERECTED, ALL GIRDERS SHALL BE BRACED TO PREVENT TIPPING UNTIL THE INTERMEDIATE DIAPHRAGMS ARE CAST AND CURED.
- THE GIRDERS MAY NEED TO BE BRACED Laterally DURING SHIPPING TO PREVENT TIPPING OR BUCKLING.
- TOP SURFACE OF THE GIRDER FLANGE SHALL BE ROUGHENED IN ACCORDANCE WITH SECTION 6-02.3(25)M OF THE STANDARD SPECIFICATIONS.
- TEMPORARY STRANDS SHALL BE CUT OFF PRIOR TO PLACING THE ROADWAY SLAB. ALL LIFTING STRANDS SHALL BE OF THE SAME MATERIAL AND STRONGER THAN EACH STRAND WILL CARRY ITS SHARE OF THE TOTAL LOAD. EXCESSIVE LIFTING LOOPS ENDING WITH A 9" LONG 180° HOOK TO WITHIN 3" CLEAR OF THE BOTTOM OF THE GIRDER.
- FOR END TYPES A, CUT ALL STRANDS FLUSH WITH THE GIRDER ENDS AND PAINT WITH AN APPROVED EPOXY RESIN. EXCEPT FOR EXTENDED STANDS AS SHOWN, SUCH A MANNER AS TO NOT CAUSE DAMAGE TO THE GIRDER DURING THE STRAND RELEASE OPERATION.
- ALL STRANDS SHALL BE D-6#9 LOW RELAXATION STRANDS (ASHTO M303 GRADE 270).
- FOR SAWTOOTH DETAILS SEE W746 GIRDER DETAILS 2 OF 2.
- TEMPORARY STRANDS ARE PRETENSIONED OR POST-TENSIONED OVER ALL IF PRETENSIONED, THESE STRANDS SHALL BE CUT OFF PRIOR TO PLACING THE ROADWAY SLAB. TEMPORARY STRANDS MAY BE POST-TENSIONED BEFORE THE GIRDER IS LIFTED FROM THE FORM. TEMPORARY STRANDS SHALL BE CUT BEFORE INTERMEDIATE DIAPHRAGMS ARE CAST.

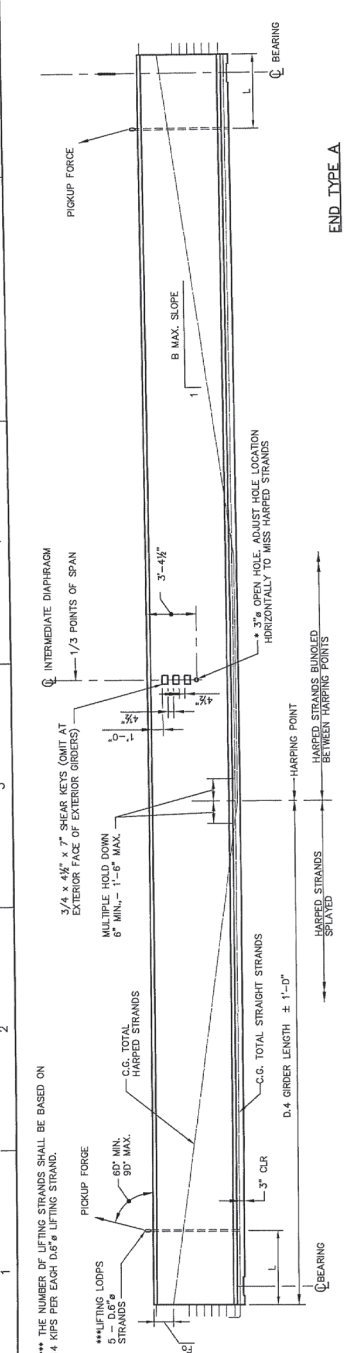

END TYPE A


GIRDER ELEVATION

* ONLY HOLES AND PLACES TO INSERTS ON THE INTERIOR FACE OF EXTERIOR GIRDERS. PLACE HOLES AND INSERTS PARALLEL TO SKIN. INSERTS SHALL BE 1" BURKE HI-TENSILE, LANCASTER MALLEABLE, DAYTON-SUPERIOR F-82 FLARED THIN SLAB (1" x 4 5/8") FERRULE INSERT OR APPROVED EQUAL. (TYP.)

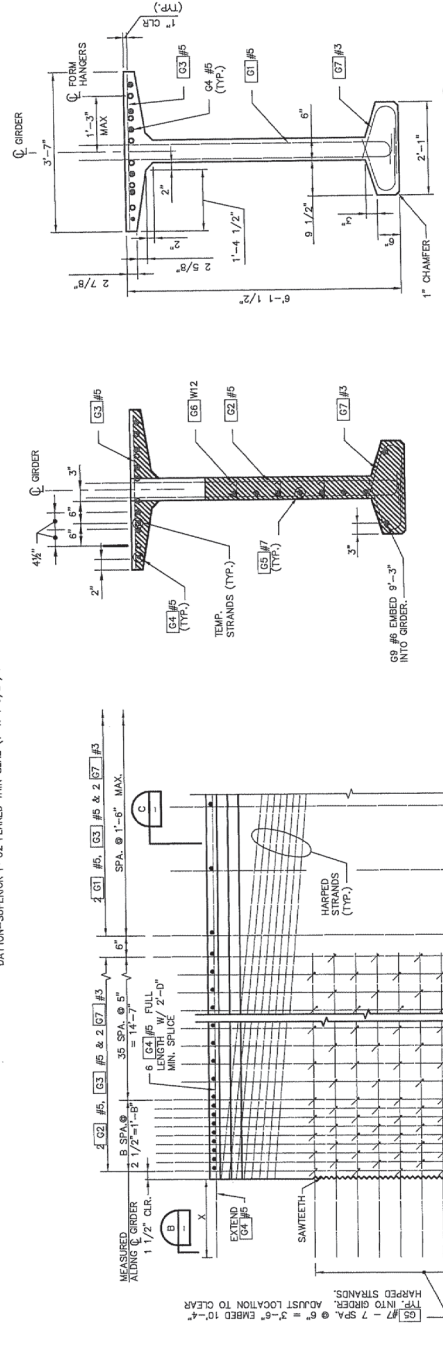

END TYPE A

TYPICAL END ELEVATION

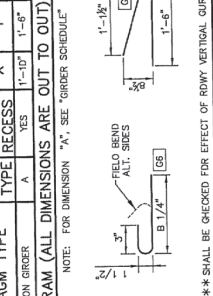

BENDING DIAGRAM (ALL DIMENSIONS ARE OUT TO OUT)

NOTE: FOR DIMENSION "A", SEE "GIRDER SCHEDULE"

MARK	LOCATION	SIZE
G1	GIRDER STRUTS	5
G2	GIRDER END STRUTS	5
G3	GIRDER TOP FLANGE	5 STR.
G4	GIRDER LONGIT. FULL LENGTH	5 STR.
G5	GIRDER END LONGIT.	5 STR.
G6	GIRDER END TIES	W12
G7	GIRDER BOT. FLANGE TIES	3
G8	GIRDER END LONGIT.	6 STR.

** SHALL BE CHECKED FOR EFFECT OF ROBY VERTICAL CURVE

OF # # # MAY BE SUBSTITUTED. FIELD BRACING IS OPTIONAL.

*** THE NUMBER OF LIFTING STRANDS SHALL BE BASED ON 14 KIPS PER EACH D-6#9 LIFTING STRAND.

*** LIFTING LOOPS STRANDS

MULTIPLE HOLD DOWN

C.G. TOTAL HARPED STRANDS

C.G. TOTAL STRAIGHT STRANDS

D.4 GIRDER LENGTH ± 1"-0"

HARPED STRANDS

HARPED STRANDS BLENDED BETWEEN HARPING POINTS

HARPING POINT

HARPED STRANDS

HARPED STRANDS

8

7

6

5

4

3

2

1

USKH
CONSULTING ENGINEERS
ARCHITECTS PLANNING

HDR
Hydro Engineering, Inc.

PROJECT MANAGER: MICHAEL A. MURPHY
DESIGNED BY: BRETT T. AKSSON
PATRICK T. LI
DRAWN BY: LARRY O. KELLER
PROJECT NUMBER: 22315
ISSUE DATE DESCRIPTION

MYRA ROAD EXTENSION PROJECT
CITY OF WALLA WALLA
WALLA COUNTY
WALLA COUNTY WATER DISTRICT
WALLA COUNTY COLLEGE

W746 GIRDER DETAILS 1 OF 2

SCALE: NO SCALE

FILE NAME: DDB-DB.dwg

SHEET B-09


W746 GIRDER DETAILS 1 OF 2

W746 GIRDER DETAILS 1 OF 2


W746 GIRDER DETAILS 1 OF 2

W746 GIRDER DETAILS 1 OF 2


1 2 3 4 5 6 7 8

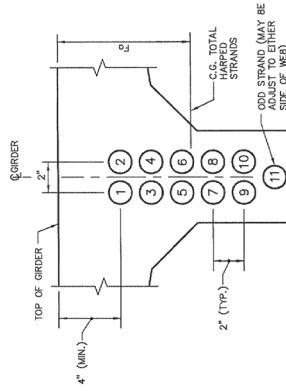


STRAND PATTERN AT GIRDER END
 HARPED STRAND LOCATION SEQUENCE SHALL BE AS SHOWN (1), (2) ETC.

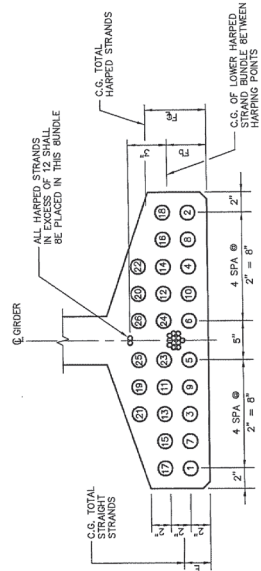

STRAND PATTERN AT Q SPAN
 STRAND LOCATION SEQUENCE SHALL BE AS SHOWN (1), (2) ETC.

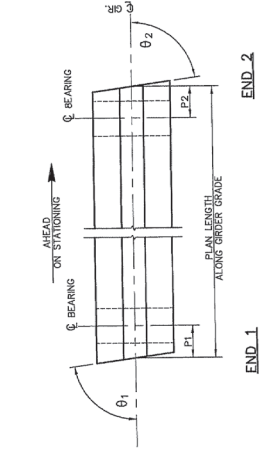

END 1
END 2

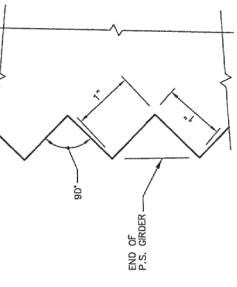


SAWTOOTH DETAILS
 SAWTEETH ARE FULL WIDTH - USE SAWTOOTH KEYS FROM END OF STRANDS TO END OF GIRDER. ADJACENT TO HARPED STRANDS AS SHOWN IN VIEW B - WEB GIRDER DETAILS 1 OF 3


GIRDER SCHEDULE

BASED ON GIRDER DEFLECTION = "0" AT TIME OF SLAB PLACEMENT (20 DAYS)


DIMENSION "A" AT Q BEARINGS = 11"	GIRDER	END 2 TYPE	END 1 TYPE	L	θ ₁	P ₁	P ₂	PLAN LENGTH (ALONG GIRDER GRADE)	MIN. CONC. COMPR. STRENGTH	HARPED		STRAIGHT		TEMPORARY		LOCATION OF C.G. STRANDS (IN.)		E	F _b	F _o	2.20	3.36	3.71
										NO. OF STRANDS	JACKING FORCE (KIPS)	NO. OF STRANDS	JACKING FORCE (KIPS)	NO. OF STRANDS	JACKING FORCE (KIPS)	E	F _b						
1	ALL	A	A	2'-0"	82.1	82.1	2'-2 1/4"	2'-2 1/4"	9.0	8.0	22	966.7	20	878.9	6	263.7	3.20	4.36	3.00	14.00	2.20	3.36	3.71

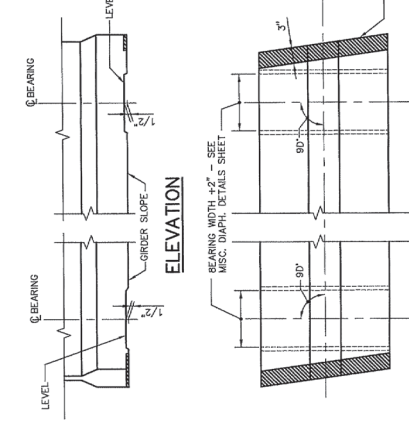


PLAN - BEARING RECESS AND BOTTOM FLANGE SPALL PROTECTION DETAIL

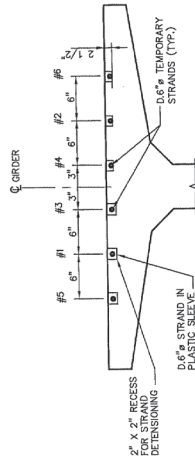

TEMPORARY STRAND BLOCKOUT DETAIL

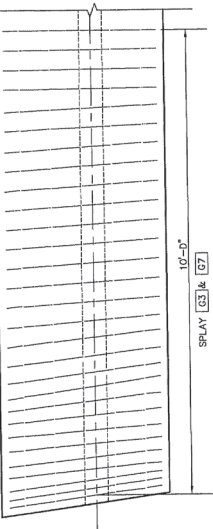



TRANSVERSE REINFORCING SKEWED ENDS
 ONLY TRANSVERSE REINF. SHOWN

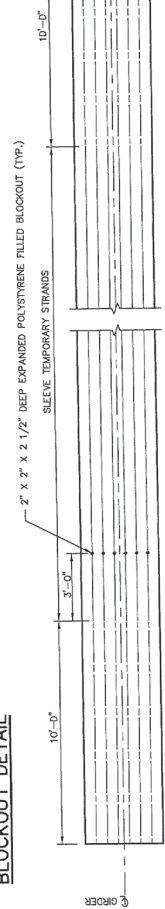

PLAN VIEW OF TEMPORARY STRANDS



PROJECT MANAGER: MICHAEL A. MURRAY
 DESIGNED BY: BRETT T. AKENSON
 PATRICK T. LI
 DRAWN BY: LARRY D. KELLER

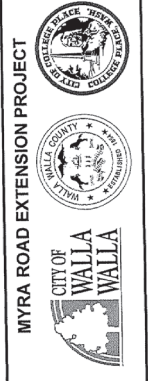
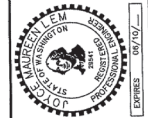


MYRA ROAD
 MILL CREEK BRIDGE
 W74G GIRDER DETAILS 2 OF 2

FILENAME: 008-10.rwg
 SCALE: NO SCALE
 SHEET: B-10

ISSUE	DATE	DESCRIPTION

PROJECT NUMBER: 22315
 DATE: 09/20/11

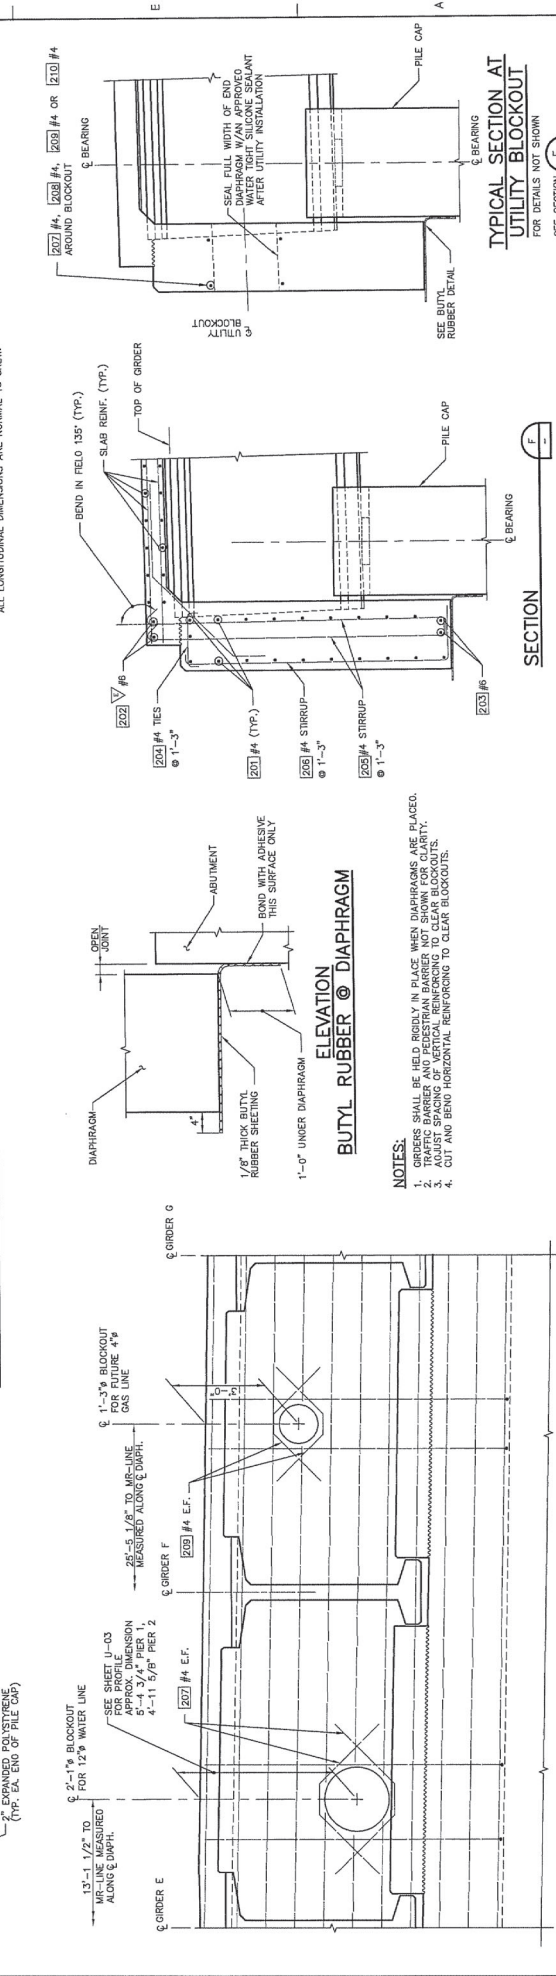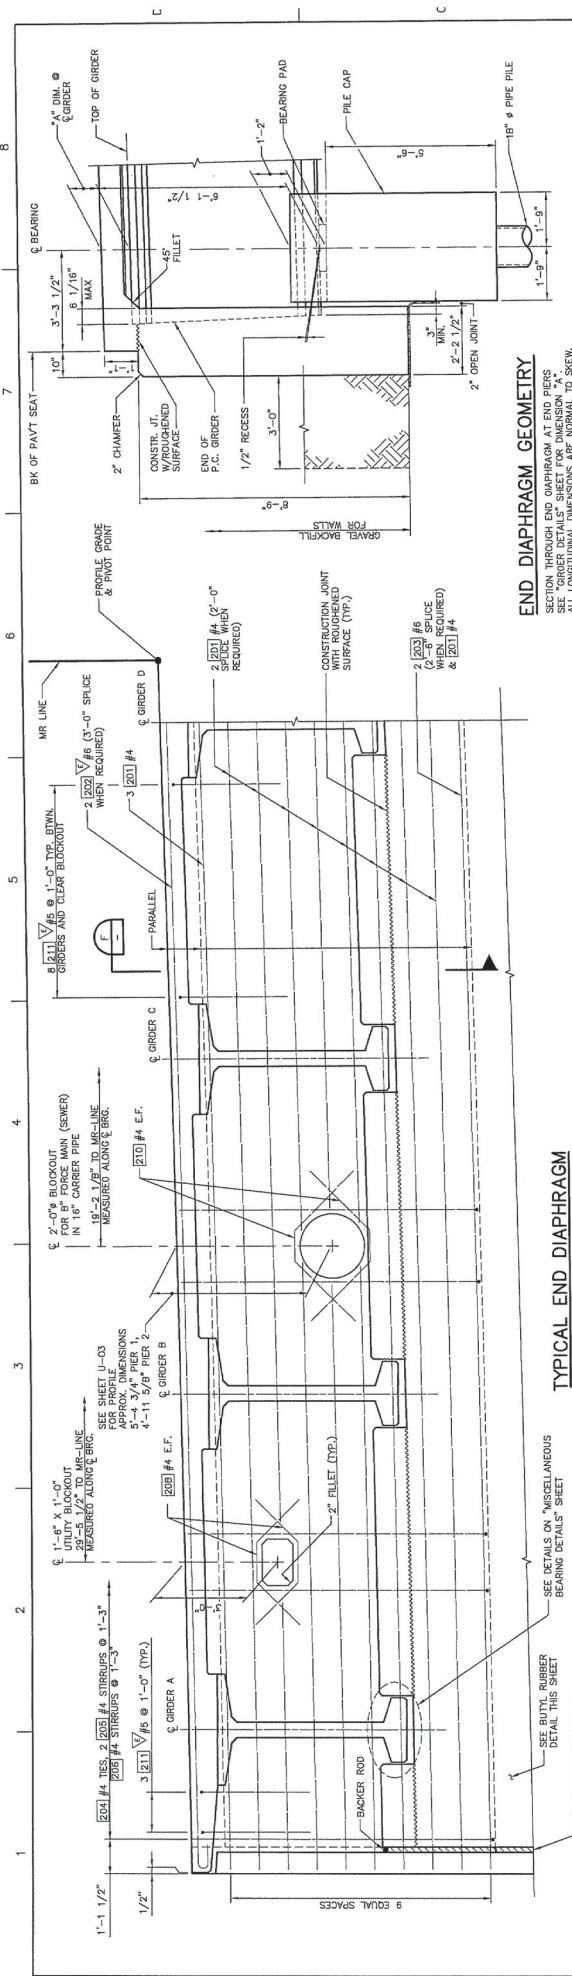

- NOTES:**
- GIRDERS SHALL BE HELD RIGIDLY IN PLACE WHEN DIAPHRAGMS ARE PLACED.
 - TRAFFIC BARRIER AND PEDESTRIAN BARRIER NOT SHOWN FOR CLARITY.
 - REINFORCEMENT DIMENSIONS ARE NORMAL TO SKEW.
 - CUT AND BEND HORIZONTAL REINFORCING TO CLEAR BLOCKOUTS.

TYPICAL END DIAPHRAGM - CONT.

PROJECT MANAGER: MICHAEL A. MURPHY	DESIGNED BY: T. KESSON	DRAWN BY: LARRY D. KELLER	PROJECT NUMBER: 22215
CHECKED BY: PATRICK L. U	DATE: 06/10/11	ISSUE: DATE DESCRIPTION	

USKH
CONSULTING ENGINEERS
LAND SURVEYING • PLANNING

HDR
HDR Engineering, Inc.

CITY OF WALLA WALLA

WALLA COUNTY
WALLA COUNTY
WALLA COUNTY

MYRA ROAD EXTENSION PROJECT

MYRA ROAD
MILL CREEK BRIDGE
END DIAPHRAGM DETAILS

SCALE: NO SCALE

FILENAME: 00B-11.dwg


SHEET: B-11

1 2 3 4 5 6 7 8

41- [504] #5 ALT. SPLICED W/ [505] #5 @ 3" TOP &
 21- [506] #5 SPLICED W/ [506] #5 @ 6" BOTTOM = 10'-0"

186- [51] #5 @ 9" 83- [52] #4 @ 1'-5" 166- [53] #5 @ 9" & 83- [54] #4 @ 1'-6" (TYP. BOTH SIDES)
 206- [504] #5 ALT. SPLICED W/ [505] #5 @ 6" TOP & 206- [506] #5 SPLICED W/ [506] #5 @ 6" BOTTOM = 102'-6"

MEASURED ALONG MR LINE
 BK. OF PAVT SEAT
 3'-5 1/2"

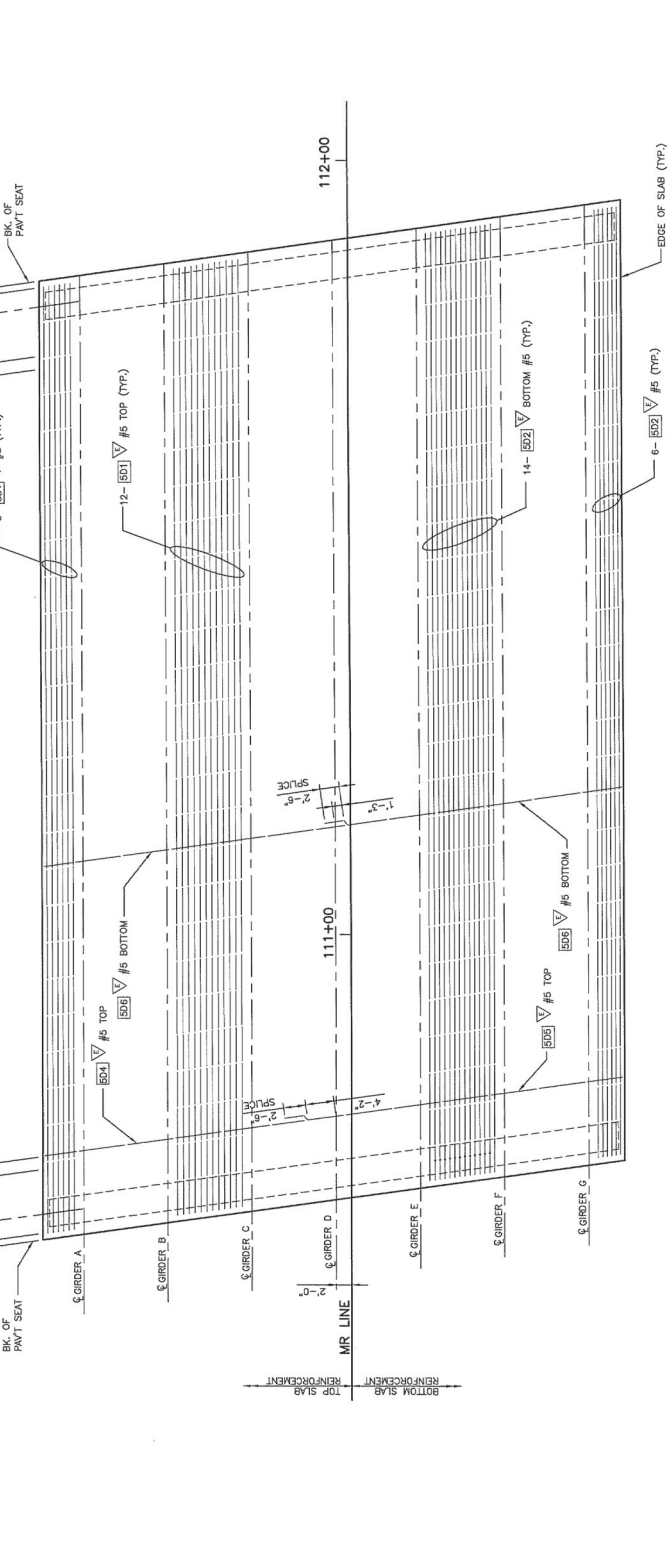


EDGE OF SLAB (TYP.)

SLAB REINFORCING PLAN

TEMPORARY STRAND CUTTING SEQUENCE

1. ERECT AND BRACE GIRDERS.
2. REMOVE EXPANDED POLYSTYRENE IN 2" X 2" RECESSES IN TOP FLANGE OF GIRDERS.
3. CAST INTERMEDIATE & END DIAPHRAGMS.
4. REMOVE AND MORTAR IN RECESS PRIOR TO FILLING RECESS WITH GROUT.
5. CAST INTERMEDIATE & END DIAPHRAGMS.
6. CAST INTERMEDIATE & END DIAPHRAGMS.
7. SEE SHEET M&S30 GORDER DETAILS 3 OF 3 FOR 2" RECESS BLOCKOUT DETAILS.

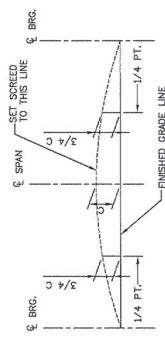

SCREED SETTING DIMENSIONS

FOR DIMENSION 'C' SEE GORDER SCHEDULE

- NOTES:
1. LOCATION OF [501] #5 & [502] #5 2'-6" LAP SPLICES AT CONTRACTOR'S OPTION. LOCATIONS SHALL BE SUCH THAT NO MORE THAN 50% OF REBAR IS SPICED AT THE SAME LOCATION.
 2. FOR DETAILS OF [51] #5 & [52] #4 BARS, SEE SHEET 9-16. FOR DETAILS OF [53] #5 & [54] #4 BARS, SEE SHEET 9-17.

MYRA ROAD
 MILL CREEK BRIDGE
 ROADWAY SLAB REINFORCEMENT PLAN

SCALE: NO SCALE

FILENAME: DOB-14.dwg

SHEET: B-14

MYRA ROAD EXTENSION PROJECT

CITY OF WALLA WALLA

WALLA COUNTY

WALLA COUNTY

MAURICE L. EM

REGISTERED PROFESSIONAL ENGINEER

EXPIRES: 06/30/20

PROJECT MANAGER: MICHAEL A. MURPHY
DESIGNED BY: BRETT T. ALESSON
DRAWN BY: LARRY D. KELLER
PROJECT NUMBER: 22315

ISSUE	DATE	DESCRIPTION

USKH

ARCHITECTURE • ENGINEERING
 LAND SURVEYING • PLANNING

HDR

HDR Engineering, Inc.


1 2 3 4 5 6 7 8

C

C



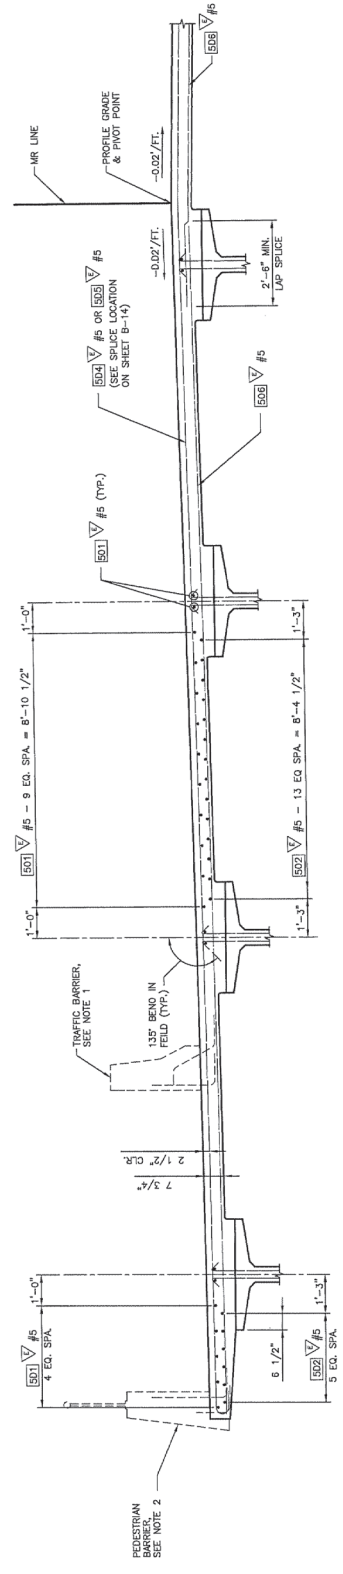

E

A




TYPICAL SECTION
 1/2" = 1'-0"
 (SECTION SHOWN NEAR MIDSPAN)

- NOTES:**
1. FOR DETAILS OF [S1] #5 & [S2] #4 BARS AT TRAFFIC BARRIERS, SEE SHEET B-16.
 2. FOR DETAILS OF [S3] #5 & [S4] #4 BARS AT PEDESTRIAN BARRIERS, SEE SHEET B-17.
 3. FOR UTILITY HANGER INSERTS AND DETAILS, SEE SHEET B-24.


 <p>USKH ARCHITECTURE • ENGINEERING LAND SURVEYING • PLANNING</p>	 <p>HDR HERR Engineering, Inc.</p>	 <p>CITY OF WALLA WALLA</p>	 <p>WALLA WALLA COUNTY</p>
<p>MYRA ROAD EXTENSION PROJECT</p>			
<p>MYRA ROAD MILL CREEK BRIDGE ROADWAY SLAB REINFORCEMENT SECTION</p>			
<p>PROJECT MANAGER: MICHAEL A. MURRAY DESIGNED BY: BRETT T. AKSSON DRAWN BY: LARRY D. KELLER</p>		<p>FILENAME: 108B-15.dwg SCALE: NO SCALE</p>	
<p>ISSUE DATE DESCRIPTION</p>		<p>SHEET B-15</p>	

DIRECTION OF TRAFFIC

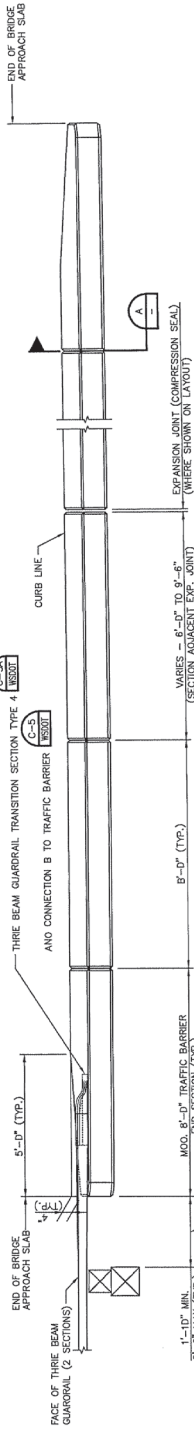


PLAN - TRAFFIC BARRIER

VARIES - 6'-0" TO 9'-6" (SECTION ADJACENT EXP. JOINT)
 EXPANSION JOINT (COMPRESSION SEAL)
 (WHERE SHOWN ON LAYOUT)

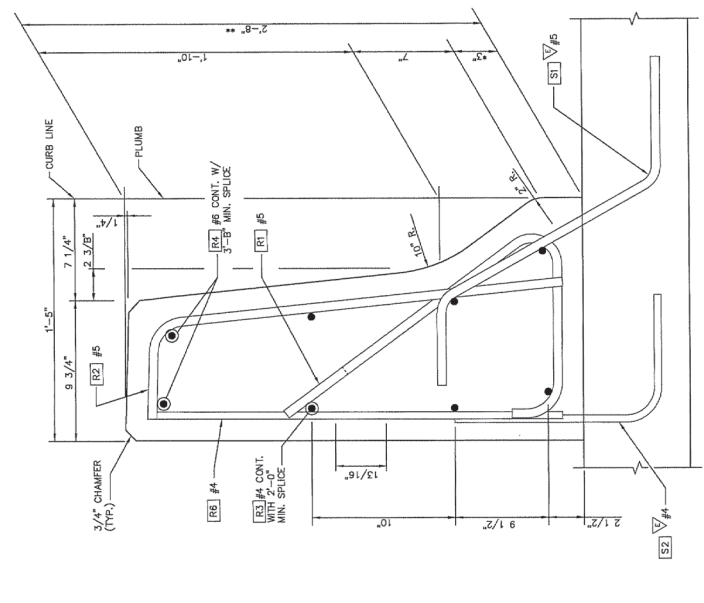

TYPICAL SECTION - TRAFFIC BARRIER

**OUTSIDE ELEVATION
 END OF APPROACH SLAB TRAFFIC BARRIER**

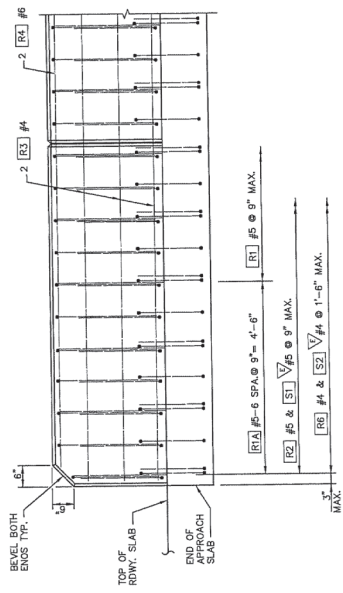

▽ DENOTES EPOXY COATED


TRAFFIC BARRIER BAR LIST

ALL REINFORCING SHALL BE ASHTO M31, GR. 60
 BENDING DIAGRAM (ALL DIMENSIONS ARE OUT TO OUT)

MARK	SIZE	LENGTH
R1	5	4'-0"
R1A	5	(A)
R2	5	2'-10"
R3	4	(A)
R4	6	(A)
R6	4	2'-0"

(A) DETERMINE FROM PLANS

FOR [S1] ▽ & [S2] ▽ BARS SEE BARLIST

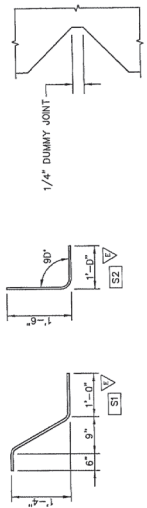

DUMMY JOINT DETAIL

* TOE HEIGHT MAY VARY, 2" MIN. TO 6" MAX.
 ** HEIGHT MAY VARY IF REQUIRED TO PROVIDE A PROFILE PLEASING TO THE EYE.

USKH
 ARCHITECTURE • ENGINEERING
 LAND SURVEYING • PLANNING

HDR
 HDR Engineering, Inc.

ISSUE	DATE	DESCRIPTION

PROJECT MANAGER: MICHAEL A. MURRAY
 DESIGNED BY: BRETT T. AKESSON
 PATRICK T. LI
 DRAWN BY: LARRY D. KELLER


JOHN WALLACE ENGINEERING
 1001 WASHINGTON
 WASHINGTON, DC 20004
 EXPRESSES 06/10/00

MYRA ROAD EXTENSION PROJECT
 CITY OF WALLA WALLA
 WALLA COUNTY
 WASHINGTON

**MYRA ROAD
 MILL CREEK BRIDGE
 TRAFFIC BARRIER DETAILS**

SCALE: 1" = 8'
 FILENAME: 00B-16.dwg
 SHEET: B-16


1 2 3 4 5 6 7 8

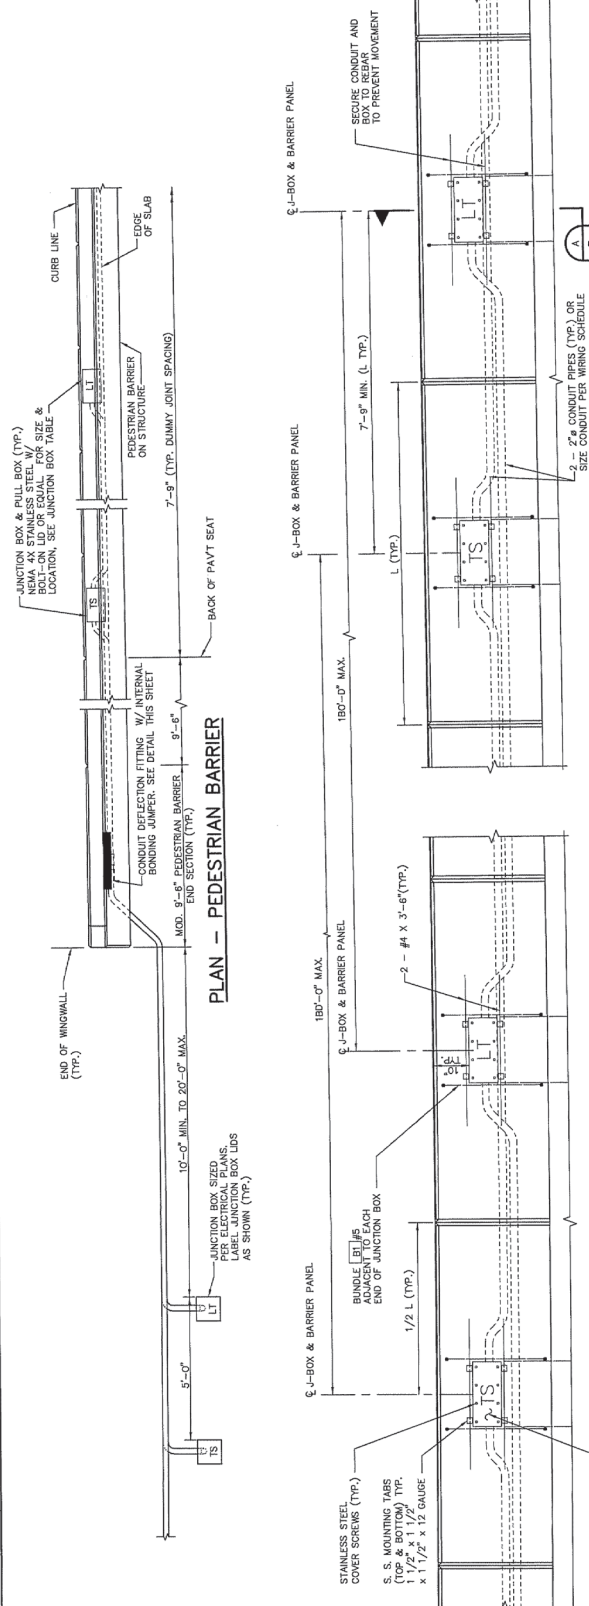

PLAN - PEDESTRIAN BARRIER

ELEVATION - CONDUITS & J-BOX IN PEDESTRIAN BARRIER

ADJACENT JUNCTION BOXES ARE SHOWN CENTERED BETWEEN ADJACENT DUMMY JOINTS. IF THE DISTANCE BETWEEN ADJACENT DUMMY JOINTS IS 18'-0" OR GREATER, PLACE ADJACENT JUNCTION BOXES SYMMETRICALLY ON EITHER SIDE OF THE CENTER OF ONE DUMMY PANEL WHILE MAINTAINING 8'-0" MINIMUM BETWEEN CENTER LINES OF THE JUNCTION BOXES.

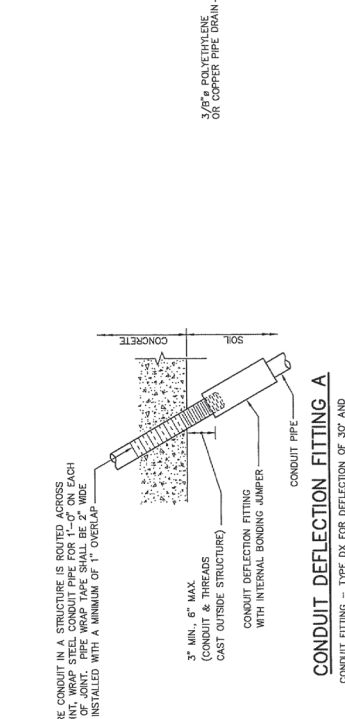

CONDUIT DEFLECTION FITTING A

CONDUIT FITTING - TYPE DX FOR DEFLECTION OF 30° AND 3/4" MOVEMENT. PLACE AT CONDUIT PIPE EXIT FROM STRUCTURE

JUNCTION BOX LOCATIONS ARE SHOWN IN THIS SECTION BOX INSTALLATION BETWEEN BARRIER DUMMY JOINTS

STATION	OFFSET	LABEL
MR 110+55.25	LT	LT
MR 110+58.75	RT	LT
MR 111+98.25	LT	LT
MR 112+02.75	RT	LT

TS = TRAFFIC SYSTEM
 LT = LIGHTING SYSTEM
 INSTALL ALL CONDUIT RUNS TO DRAIN TO LOW POINTS IN CONDUIT RUN ON BRIDGE.

USKH
 ENGINEERING
 ARCHITECTURE - PLANNING
 AND CONSTRUCTION

HDR
 HDR Engineering, Inc.

WALLA COUNTY
 CITY OF WALLA WALLA

WALLA COUNTY WATER REUSE
 WALLA COUNTY WATER REUSE PROJECT


WALLA COUNTY WATER REUSE PROJECT
 MYRA ROAD EXTENSION PROJECT
 PEDESTRIAN BARRIER DETAILS 2 OF 2

ISSUE	DATE	DESCRIPTION

PROJECT MANAGER: MICHAEL A. MURRAY
 DESIGNED BY: BRETT T. AKSSON
 PATRICK T. LI
 DRAWN BY: LARRY D. KELLER
 PROJECT NUMBER: 22315

EXPIRES: 03/07/2025

FILE NAME: DDB-18.dwg
 SCALE: NO SCALE
 SHEET: B-18

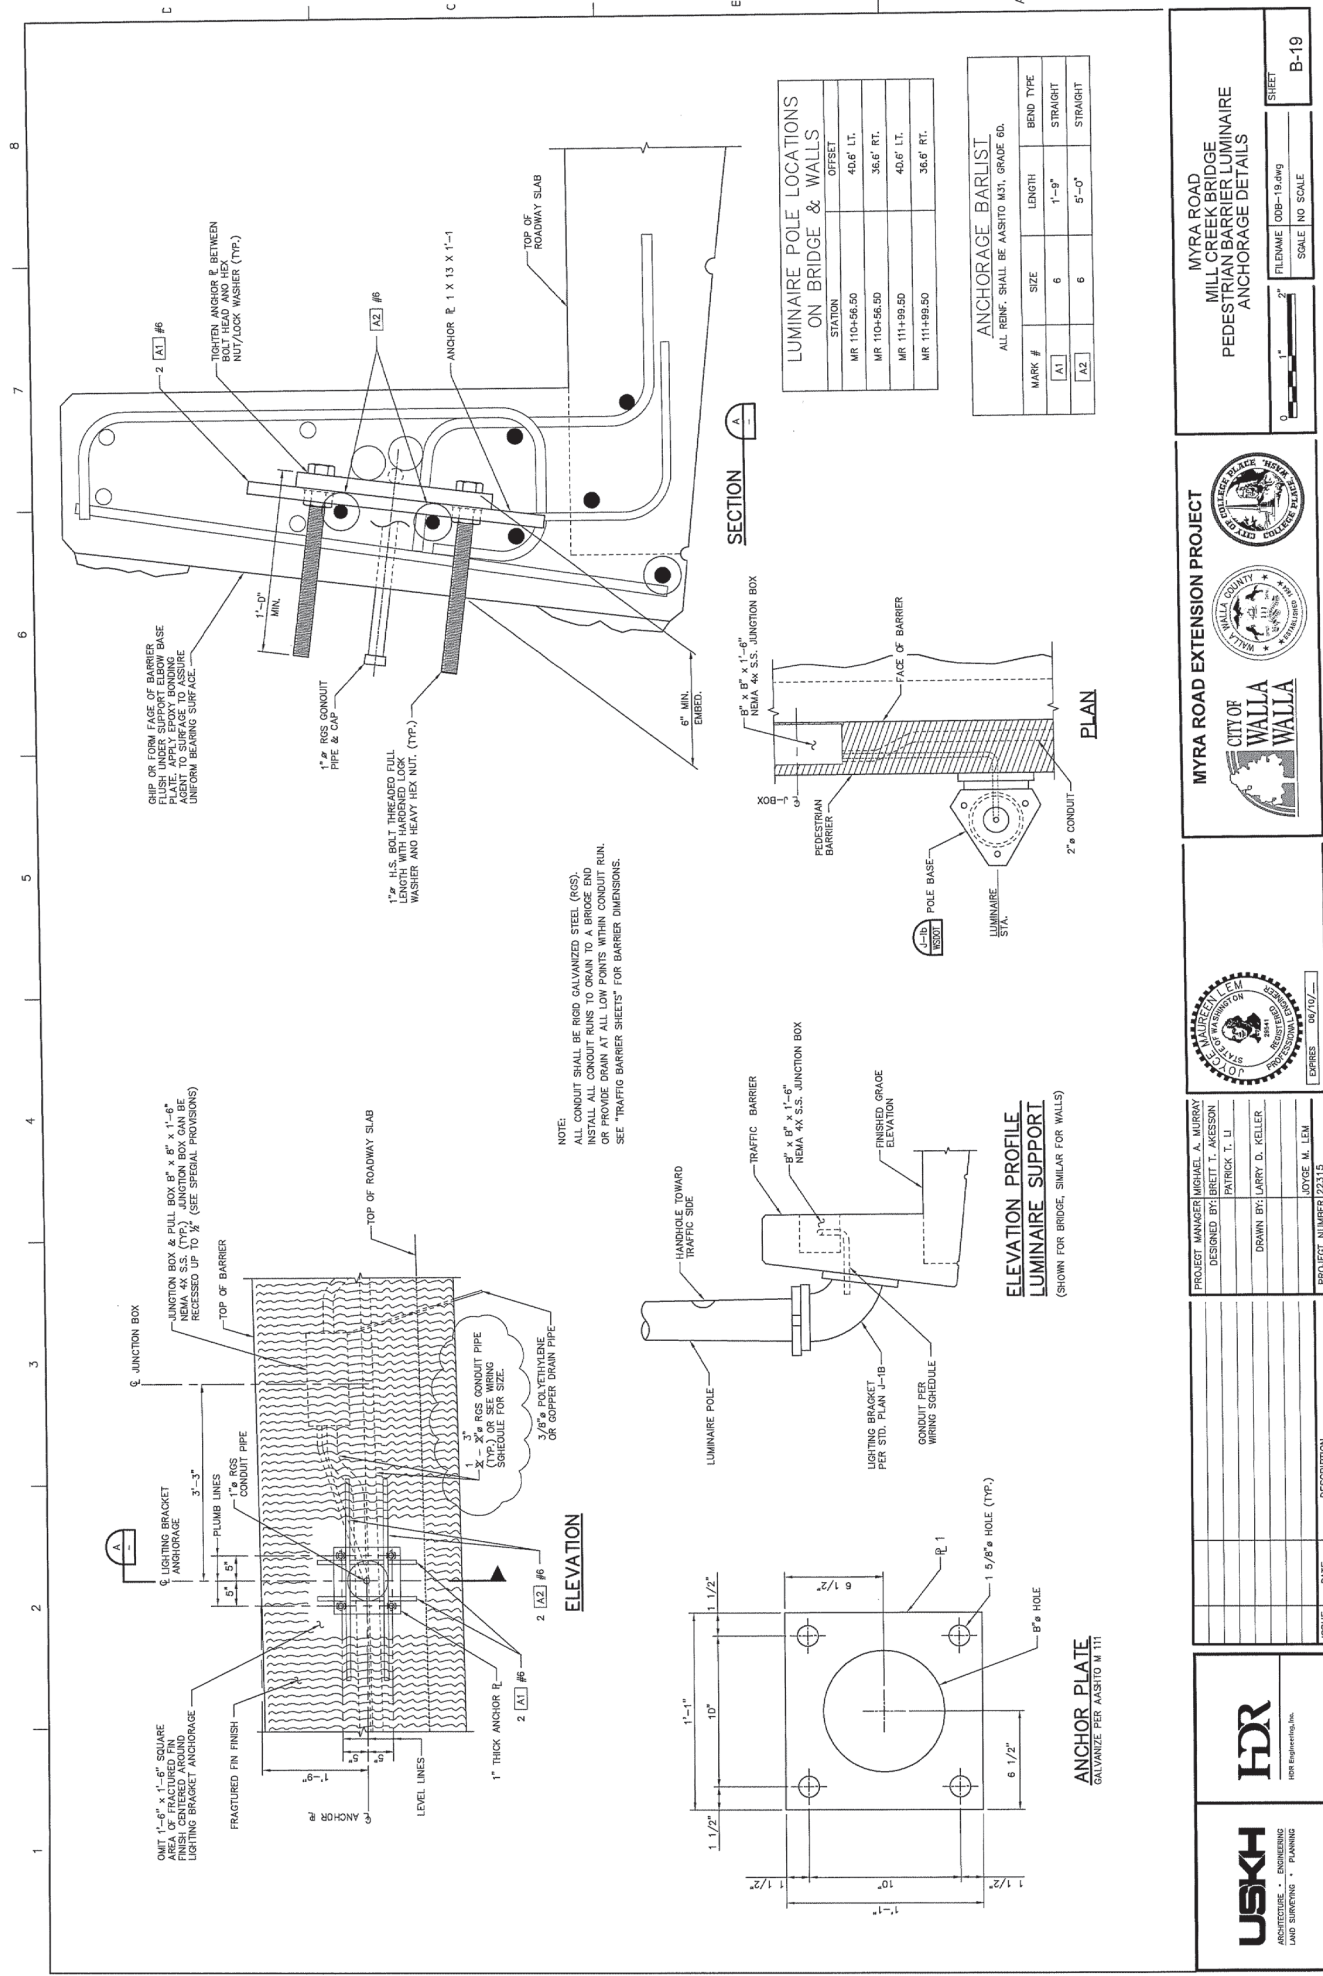

LUMINAIRE POLE LOCATIONS ON BRIDGE & WALLS

STATION	OFFSET
MR 110+56.50	40.6' LT.
MR 110+56.50	36.6' RT.
MR 111+99.50	40.6' LT.
MR 111+99.50	36.6' RT.

ANCHORAGE BARLIST
ALL REIN. SHALL BE AASHTO M31, GRADE 60.

MARK #	SIZE	LENGTH	BEND TYPE
A1	6	1'-9"	STRAIGHT
A2	6	5'-0"	STRAIGHT

NOTE:
ALL CONDUIT SHALL BE RIGID GALVANIZED STEEL (RGS).
NESTING SHALL BE PERMITTED TO A BRIDGE END
OR PROVIDE DRAIN AT ALL LOW POINTS WITHIN CONDUIT RUN.
SEE "TRAFFIC BARRIER SHEETS" FOR BARRIER DIMENSIONS.

MYRA ROAD EXTENSION PROJECT
MILL CREEK BRIDGE
PEDESTRIAN BARRIER LUMINAIRE ANCHORAGE DETAILS

SCALE: 1" = 1'-0"
FILENAME: 00B-19.dwg
SCALE: 1/8" = 1'-0"

SHEET: B-19

MYRA ROAD EXTENSION PROJECT
CITY OF WALLA WALLA
WALLA COUNTY
WALLA COUNTY HEALTH DEPARTMENT


WALLA COUNTY
PLANNING & ZONING DEPARTMENT
DESIGNED BY: MICHAEL A. MURPHY
DESIGNED BY: BRETT T. AKESON
DRAWN BY: PATRICK T. LI
DRAWN BY: LARRY D. KELLER
PROJECT NUMBER: 22315
ISSUES: 06/20/11

ISSUE	DATE	DESCRIPTION

USKH
ARCHITECTURE ENGINEERING PLANNING AND CONSTRUCTION


HDR
HYDROLOGICAL ENGINEERING

1 2 3 4 5 6 7 8

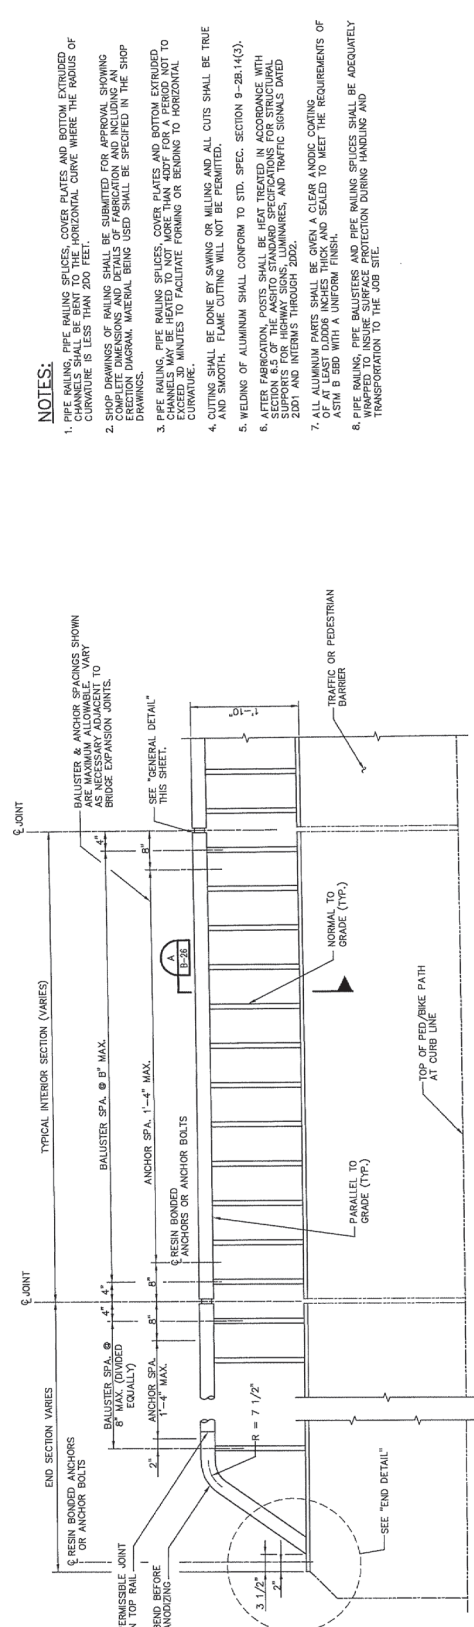

- NOTES:**
1. PIPE RAILING, PIPE RAILING SPICES, COVER PLATES AND BOTTOM EXTENDED SPICES SHALL BE HEAT TREATED TO A MINIMUM OF 200°F. THE RADIUS OF CURVATURE IS LESS THAN 200 FEET.
 2. SPOD DIMENSIONS OF RAILING SHALL BE SUBMITTED FOR APPROVAL SHOWING COMPLETE DIMENSIONS AND DETAILS OF FABRICATION AND INCLUDING AN ERECTION DIAGRAM. MATERIAL BEING USED SHALL BE SPECIFIED IN THE SHOP DRAWINGS.
 3. PIPE RAILING, PIPE RAILING SPICES, COVER PLATES AND BOTTOM EXTENDED SPICES SHALL BE HEAT TREATED TO NOT MORE THAN 400°F FOR A PERIOD NOT TO EXCEED 30 MINUTES TO FACILITATE FORMING OR BENDING TO HORIZONTAL CURVATURE.
 4. CUTTING SHALL BE DONE BY SAWING OR MILLING AND ALL CUTS SHALL BE TRUE AND SMOOTH. FLAME CUTTING WILL NOT BE PERMITTED.
 5. WELDING OF ALUMINUM SHALL CONFORM TO STD. SPEC. SECTION 9-28.1(4)(3).
 6. AFTER FABRICATION, POSTS SHALL BE HEAT TREATED IN ACCORDANCE WITH SECTION 8.5 OF THE AASHTO STANDARD SPECIFICATIONS FOR BRIDGES, BUILT UP AND INTERMS THROUGH 2002.
 7. ALL ALUMINUM PARTS SHALL BE GIVEN A CLEAR ANODIC COATING OF AT LEAST 0.0008 INCHES THICK AND SEALED TO MEET THE REQUIREMENTS OF ASTM B 55D WITH A UNIFORM FINISH.
 8. PIPE RAILING, PIPE RAILING SPICES AND PIPE RAILING SPICES SHALL BE ADEQUATELY PROTECTED AGAINST CORROSION DURING HANDLING AND TRANSPORTATION TO THE JOB SITE.


ELEVATION
RAILINGS AND GUARDRAIL SECTION
ATTACHMENT DETAILS NOT SHOWN.

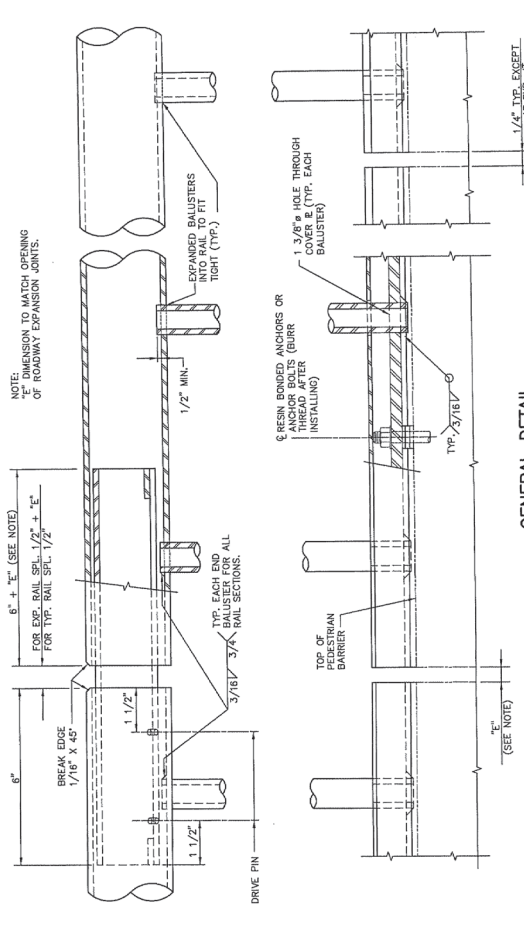


GENERAL DETAIL

					MYRA ROAD EXTENSION PROJECT BRIDGE RAILING TYPE BP DETAILS 1 OF 2	SHEET B-20
					FILENAME: 00B-20.dwg SCALE: NO SCALE	
PROJECT MANAGER: MICHAEL A. MURRAY DESIGNED BY: BRETT T. AKENSON DRAWN BY: LARRY D. KELLER		PROJECT NUMBER: 22315		ISSUE DATE DESCRIPTION		

1 2 3 4 5 6 7 8

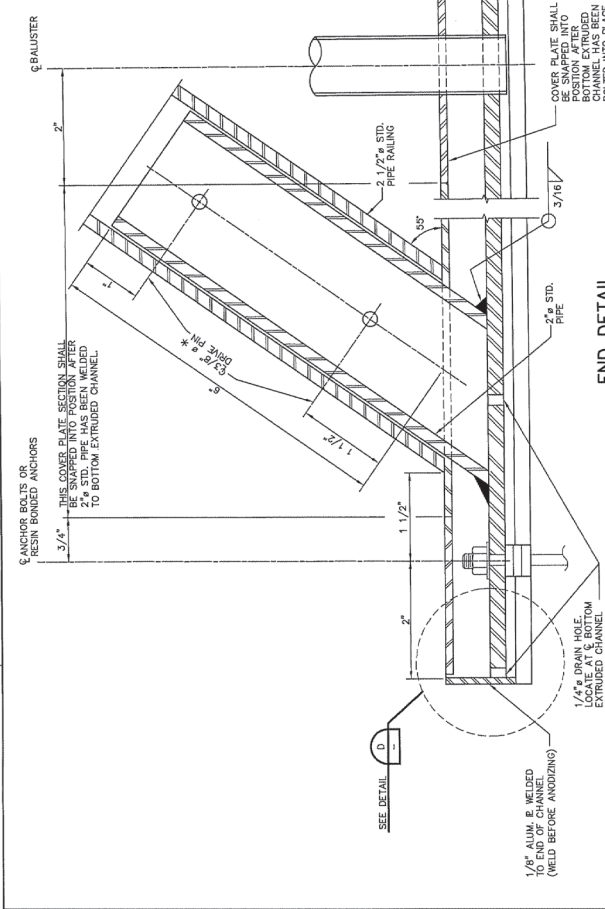


END DETAIL

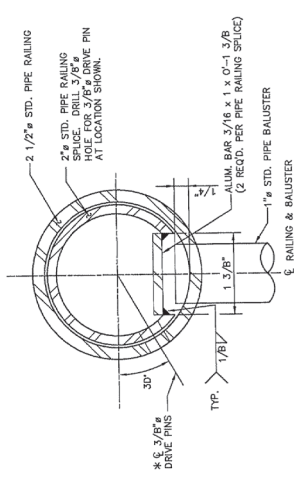


DETAIL OPTION #1

* LOCATE ON OPPOSITE SIDE OF TRAFFIC. DRIVE PINS SHALL BE DRIVEN FLUSH WITH THE OUTSIDE FACE OF THE RAILING.

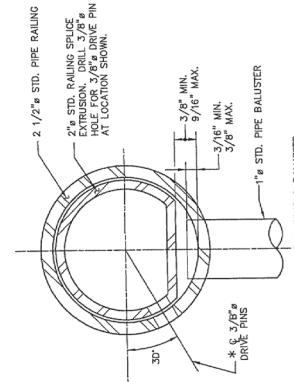


DETAIL OPTION #2

* LOCATE ON OPPOSITE SIDE OF TRAFFIC. DRIVE PINS SHALL BE DRIVEN FLUSH WITH THE OUTSIDE FACE OF THE RAILING.

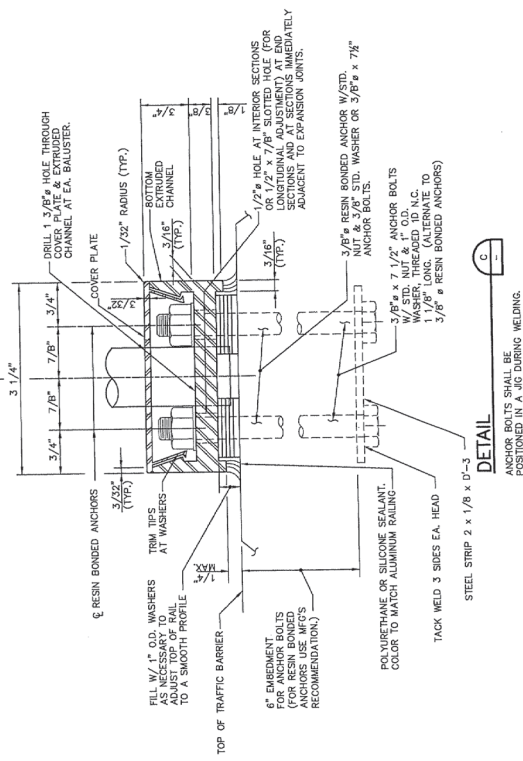

SECTION

ANCHOR BOLTS SHALL BE POSITIONED IN A JIG DURING WELDING.

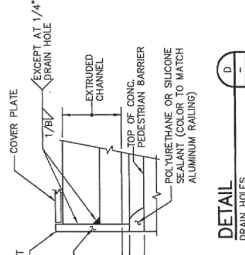


DETAIL D

PART	MATERIAL SPECIFICATION
PIPES	ASTM B221 - 6005-15 ASTM B241 OR B429 6061-T6
EXTRUDED CHANNELS & BAR COVER PLATES & BAR	ASTM B221 - 6005-15
ANCHOR BOLTS, NUTS & WASHERS	AASHTO M164 (GALVANIZE IN ACCORDANCE WITH AASHTO SPECIFICATION M252)
STRIP	ASTM A36
DRIVE PINS	ASTM A-276 TYPE 302 STAINLESS STEEL

<p>MYRA ROAD EXTENSION PROJECT MILL CREEK BRIDGE BRIDGE RAILING TYPE BP DETAILS 2 OF 2</p>				<p>FILENAME: DRP-21.dwg SCALE: NO SCALE SHEET: B-21</p>	<p>PROJECT NUMBER: 22315</p>
<p>PROJECT MANAGER: MICHAEL A. MURPHY DESIGNED BY: BRETT T. AKENSON DRAWN BY: LARRY D. KELLER</p>		<p>PROJECT MANAGER: MICHAEL A. MURPHY DESIGNED BY: BRETT T. AKENSON DRAWN BY: LARRY D. KELLER</p>		<p>ISSUE DATE DESCRIPTION</p>	

NOTES:

1. ALL ENDS OF BRIDGE APPROACH SLAB SHALL HAVE 1/2" RADIUS.
2. LONGITUDINAL JOINTS SHALL BE PLACED ON LANE LINES AND SHALL BE CONSTRUCTED AND SEALED AS SHOWN. A SAW CUT CRACK CONTROL JOINT OR A CONSTRUCTION JOINT SHALL BE USED AT THE END OF THE BRIDGE APPROACH BEFORE REACHING EDGE OF SLAB AND MUST BE SAW CUT AS SOON AS POSSIBLE AFTER PLACEMENT OF CONCRETE.
- (A) BRIDGE APPROACH SLABS LESS THAN 40' WIDE - NO JOINT IS REQUIRED.
- (B) BRIDGE APPROACH SLABS MORE THAN 40' WIDE - ONE OR MORE JOINTS ARE REQUIRED TO DIVIDE THE SLAB INTO APPROXIMATELY 24' WIDE SECTIONS.

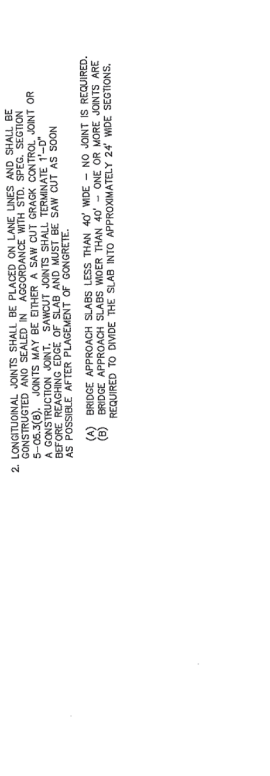


TYPICAL LONGITUDINAL CRACK CONTROL JOINT DETAIL

TYPICAL LONGITUDINAL CONSTRUCTION JOINT




EDGE FIRST PAIR ONLY WITH 1/8" RADIUS.

PLAN

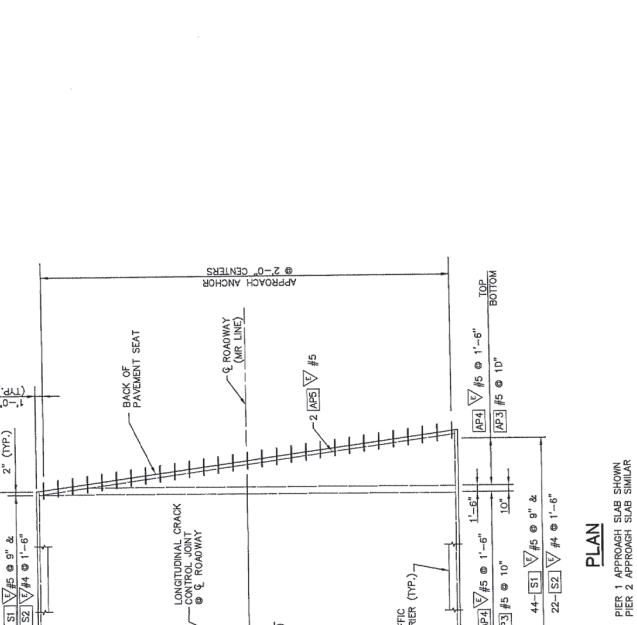

LONGITUDINAL SECTION

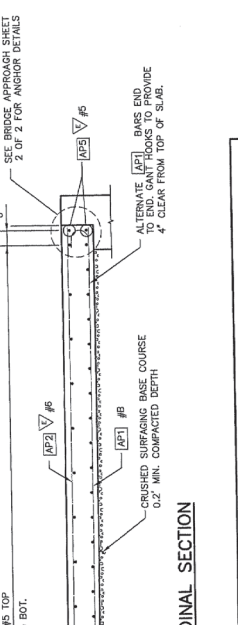

PIER 1 APPROACH SLAB SHOWN
PIER 2 APPROACH SLAB SIMILAR

SEE BRIDGE APPROACH SHEET 2 OF 2 FOR ANCHOR DETAILS

ALTERNATE #1 BASE END ANCHOR HOOKS TO PROVIDE 4" CLEAR FROM TOP OF SLAB.

CRUSHED SURFACING BASE COURSE 0.2" MIN. COMPACTED DEPTH

AP1 #1

AP2 #2

AP3 #3

AP4 #4

AP5 #5

APPROACH SLAB BAR LIST

LOCATION	MARK #	NO.	SIZE	LENGTH
LONGITUDINAL BOTTOM	AP1	B	137	VARIES 25'-7" TO 33'-5"
LONGITUDINAL TOP	AP2	V6	137	VARIES 24'-6" TO 32'-6"
TRANSVERSE BOTTOM	AP3	5	40	VARIES 56'-6" TO 5'-11"
TRANSVERSE TOP	AP4	V5	23	VARIES 86'-6" TO 10'-6"
TRANSVERSE END BAR	AP5	V5	2	57'-0"

SEE BARLIST FOR BENDING DETAILS OF TRAFFIC BARRIER BARS (S1) & (S2) ALL REINFORCING BARS SHALL BE EPOXY COATED UNLESS NOTED OTHERWISE.

V = EPOXY COATED REINFORCING STEEL

VARIES 24' - 6" TO 32' - 6"

BRIDGE

APPROACH SLAB

TRAFFIC BARRIER

USKH ARCHITECTURE • ENGINEERING LAND SURVEYING • PLANNING

HDR

www.hdrinc.com

ISSUE	DATE	DESCRIPTION

PROJECT MANAGER: MICHAEL A. MERRY
DESIGNED BY: BRETT T. AKERSON
DRAWN BY: LARRY D. KELLER
PROJECT NUMBER: 22315

MYRA ROAD EXTENSION PROJECT

CITY OF WALLA WALLA

WALLA COUNTY


WALLA COUNTY WATER DISTRICT

MYRA ROAD BRIDGE


BRIDGE APPROACH SLAB DETAILS 1 OF 2

FILE NAME: DDB-22.dwg
SCALE: NO SCALE
SHEET: B-22


NOTE: METAL COMPONENTS OF APPROACH
 PAINT WITH AN ORGANIC ZINC
 OR FORMULA A-1-159 PAINT IN ACCORDANCE
 WITH STD. SPEC. 9-08.2.

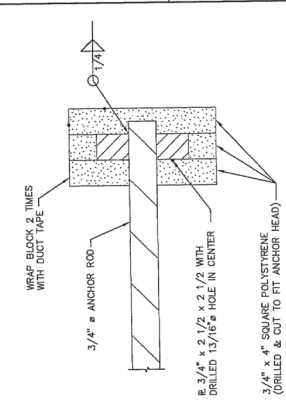


ANCHOR HEAD DETAIL

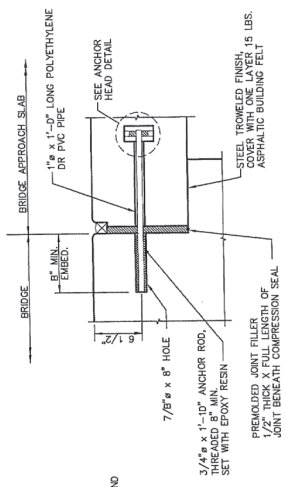

APPROACH ANCHOR - METHOD B
 SEMI-INTEGRAL TYPE ONLY

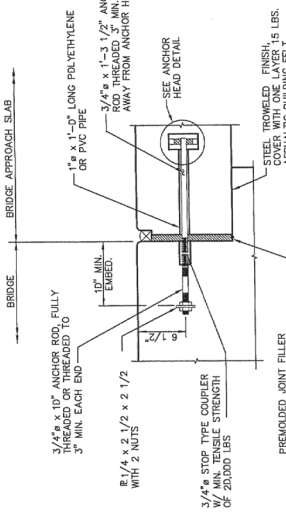

APPROACH ANCHOR - METHOD A
 SEMI-INTEGRAL TYPE ONLY

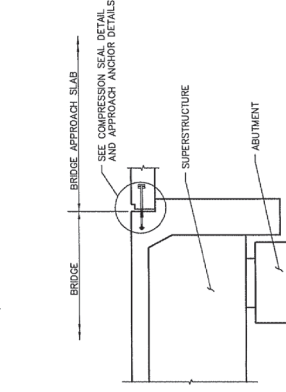


SEMI-INTEGRAL TYPE ABUTMENT


COMPRESSION SEAL TABLE

D.S. BROWN SEAL	WATSON BOWMAN SEAL	W (in.)	W (in.)
CY-2502	WA-250	2 1/2"	2 1/2"


TESTING SHALL BE PER AASHTO M-222 PRIOR TO USE.

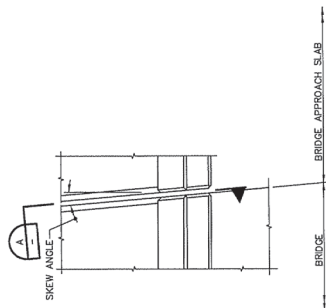

PLAN EXPANSION JOINT

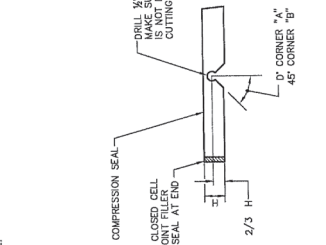


SEAL CUTTING DETAIL

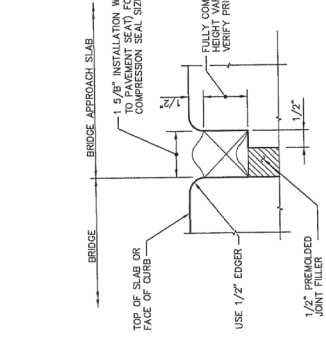

COMPRESSION SEAL DETAIL


PROJECT MANAGER: MICHAEL A. MURRAY
 DESIGNED BY: BRETT T. AKESSON
 PATRICK T. LI
 DRAWN BY: LARRY D. KELLER

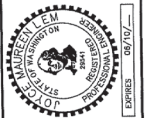

MYRA ROAD
 MILL CREEK BRIDGE
 BRIDGE APPROACH SLAB DETAILS 2 OF 2








FILENAME: BDB-23.dwg
 SCALE: NO SCALE

SHEET: B-23

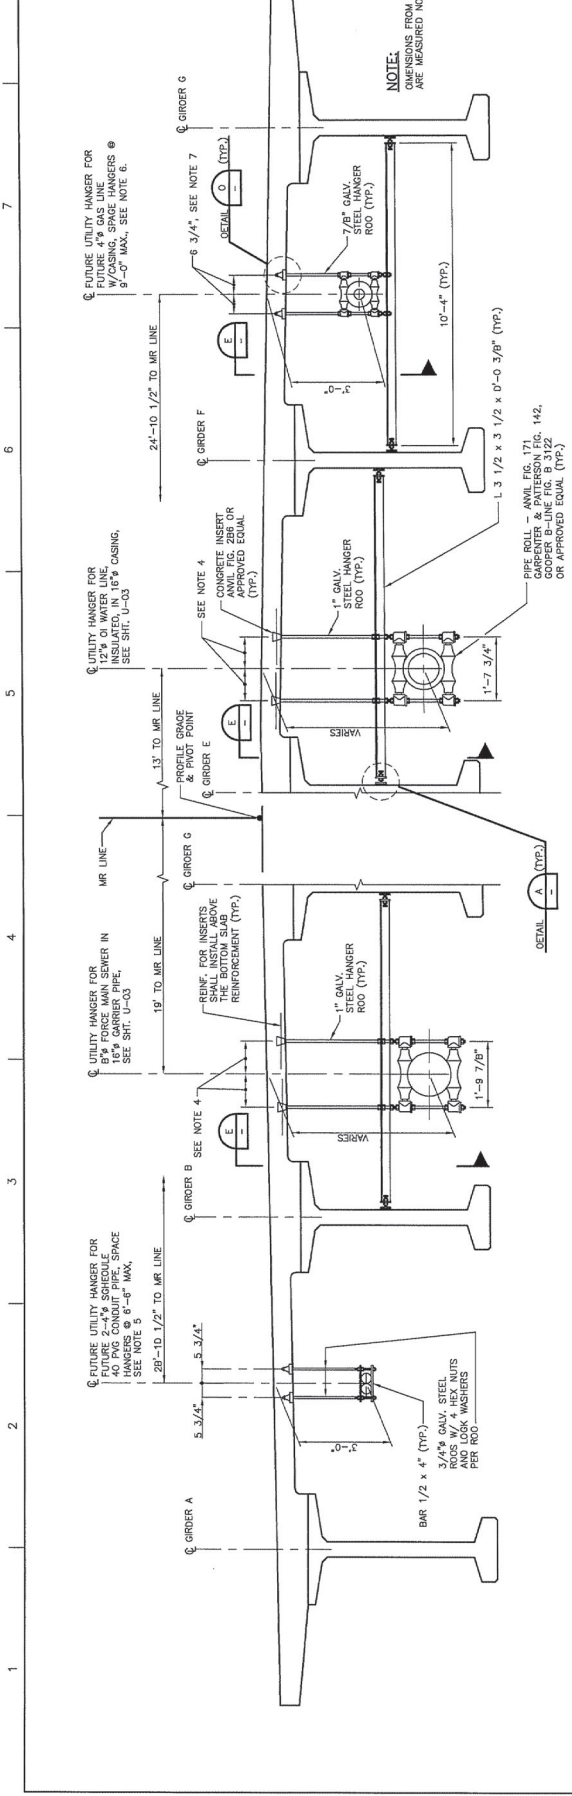

TYPICAL SECTION - UTILITY HANGERS
LOOKING SOUTH

- NOTES:**
1. ALL MATERIALS SHALL BE GALVANIZED AFTER FABRICATION, PIPE ROLLING IN 111 OR PBR300 N 232 EXCEPT CRIBWELD PIPE ROLL.
 2. SEE STR. LISTS WITH THREE COATS OF GALVANIZING REPAIR PAINT.
 3. SEE STR. LISTS FOR EXPANSION JOINTS ARE LOCATED. PROVIDE HANGER SUPPORTS AT EACH END OF JOINTS IN ACCORDANCE WITH RECOMMENDATIONS BY MANUFACTURER OF UTILITY JOINT.
 4. ADJUST DIMENSION TO MATCH PIPE ROLL.
 5. PROVIDE SLAB INSERTS ONLY. HANGER ROOS, NUTS AND PLATES NOT IN CONTRACT.
 6. PROVIDE INSERTS ONLY. HANGER ROOS, PIPE ROLLS, TRANSVERSE BRAGE NOT IN CONTRACT.
 7. 6" DIMENSION IS BASED ON ANKLE PIPE ROLL FOR 8" CASING. CONTRACTOR SHALL VERIFY THE CASING DIAMETER AND PIPE ROLLS WITH UTILITY AND ADJUST DIMENSIONS AS NECESSARY.

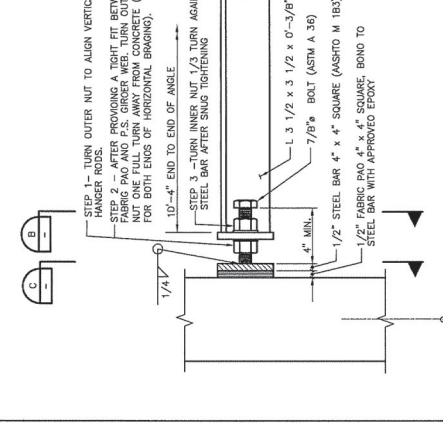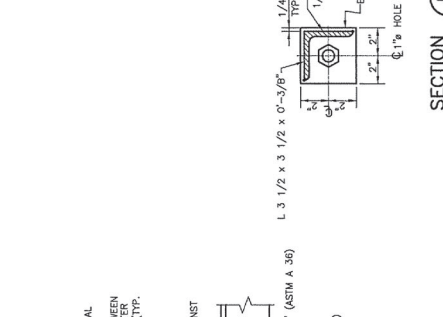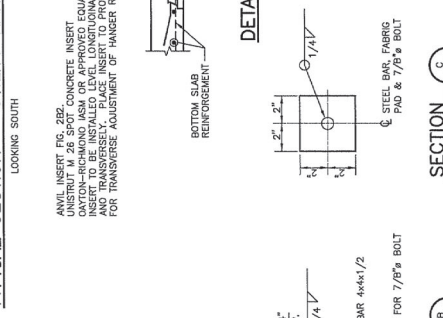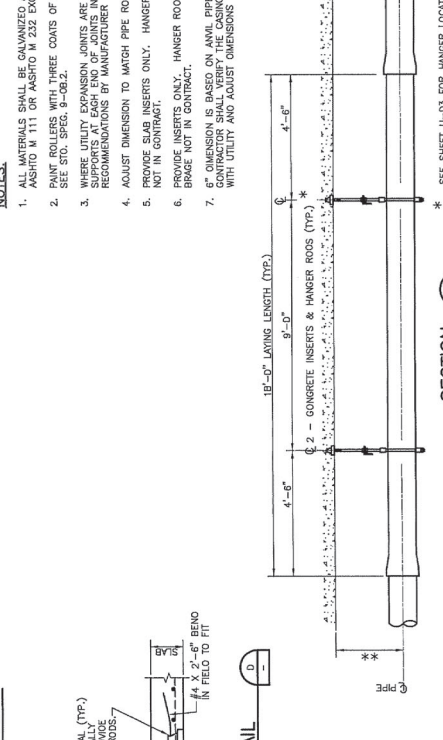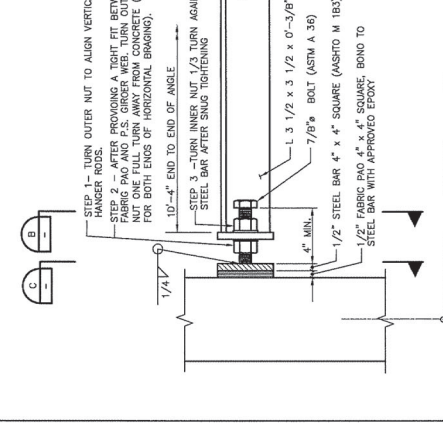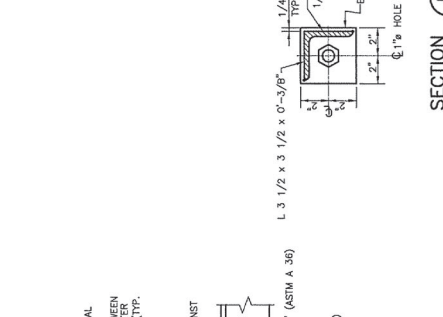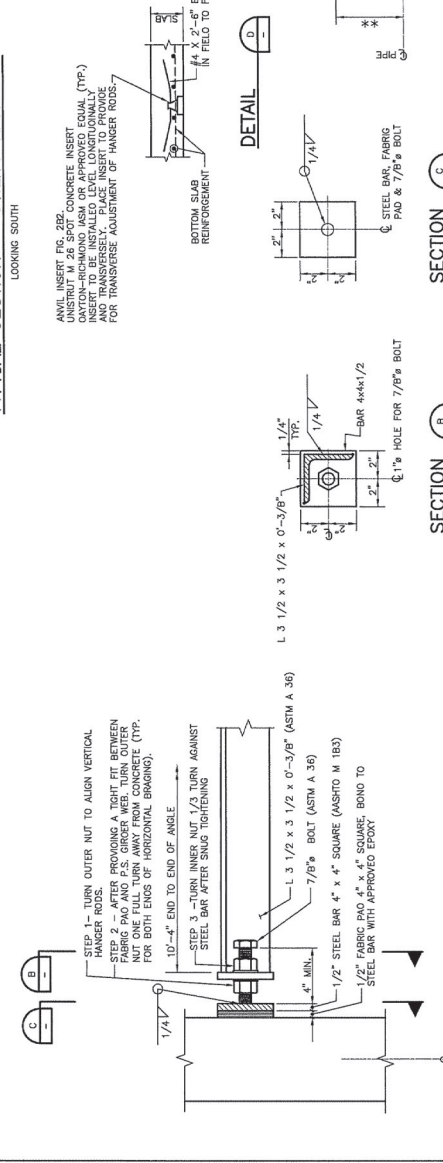

USKH
ARCHITECTURE • ENGINEERING
LAND SURVEYING • PLANNING

HDR
HDR Engineering, Inc.

MYRA ROAD EXTENSION PROJECT
CITY OF WALLA WALLA

MYRA ROAD BRIDGE MILL CREEK BRIDGE UTILITY SUPPORTS

PROJECT MANAGER: MICHAEL A. MURRAY
DESIGNED BY: BRETT T. AKERSSON
DRAWN BY: LARRY O. KELLER

ISSUE DATE DESCRIPTION

FILENAME: DBB-24.dwg
SCALE: NO SCALE
SHEET: B-24


GENERAL NOTES:

All materials and work shall be in accordance with the requirements of the State of Washington Department of Transportation (WSDOT) Standard Specifications for Road, Bridges, and Municipal Construction (English Version), dated 1998.


All cast-in-place concrete shall be class 4000 min, modified to have a minimum compressive strength of 3,000 psi per WSDOT specifications with no increase in air-entrainment from the normal class 4000 min.

All reinforcing steel shall meet the requirements of AASHTO M31, Grade 60.

The contractor shall verify all existing dimensions and shall make necessary adjustments to plan dimensions.

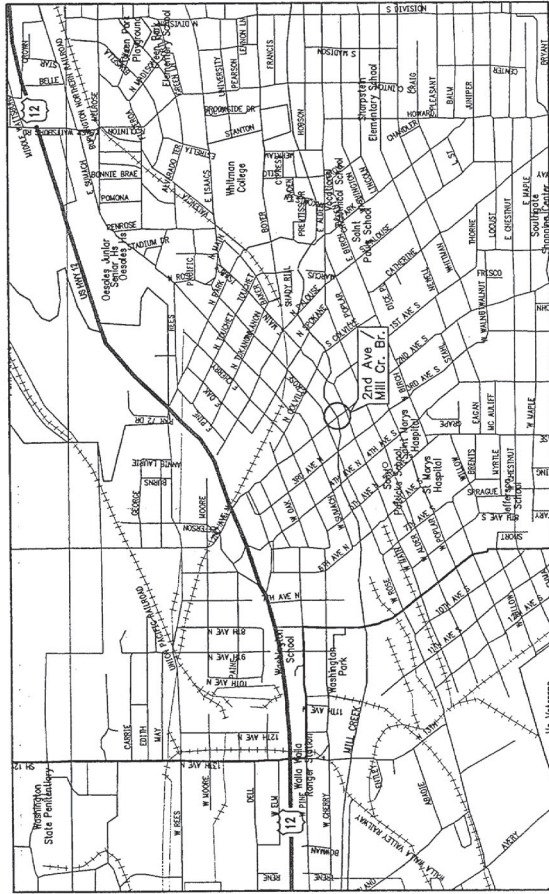


CITY OF WALLA WALLA VICINITY MAP

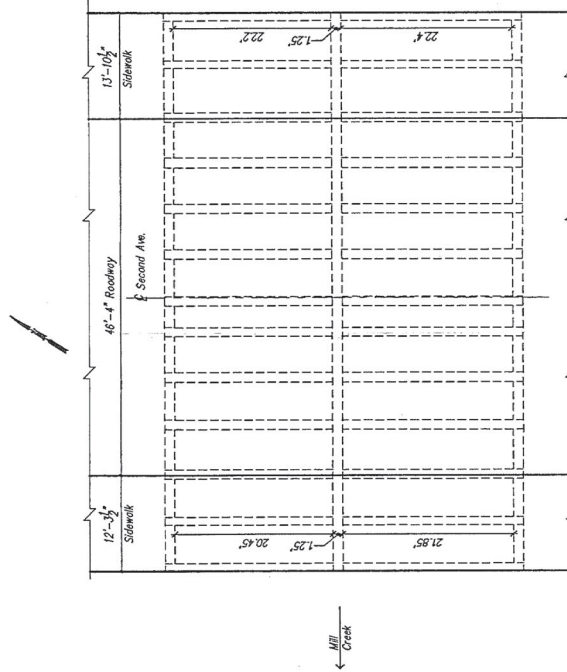


LAYOUT & FRAMING PLAN
 Located Between 2nd St. & Mill Cr.
 Centerline Stationing: 1+00.00 to 1+050.00
 For Establishing Position

DESIGNED BY: C.E. Mayton	DATE	ISSUED	BY
CHECKED BY: W.A. Whitney			
DETAILED BY: J.E. Walsh			
PROJECT NO. PWE 95-302	DATE	ISSUED	BY
FEDERAL AID PROJECT NO. WA-718(001)			
PROJECT NO. PWE 95-302			
SARGENT Sargent Engineers, Inc. 320 West Boy Drive, Suite 101 • Olympia, Washington 98502 Tel. 360 943-3590 • Fax 360 352-3581			
WALLA WALLA DEPARTMENT OF PUBLIC WORKS		SECOND AVENUE BRIDGE REHABILITATION City of Walla Walla, Washington	
ENGINEER _____ DATE _____ PROJECT NO. _____		VICINITY MAP & FRAMING PLAN SHEETS 3 OF 1 97235	

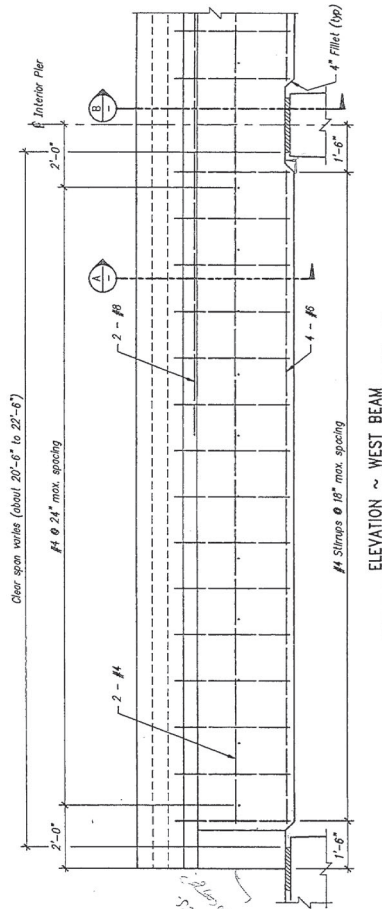


ELEVATION ~ WEST BEAM

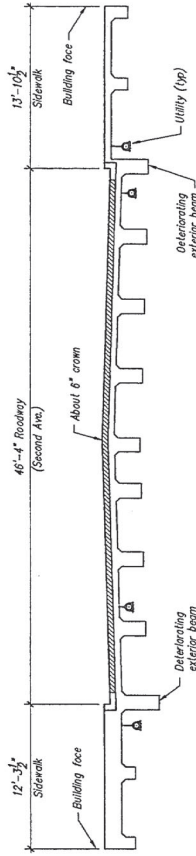


SECTION THRU SUPERSTRUCTURE

(Normal to Second Avenue)
Looking North-Northeast

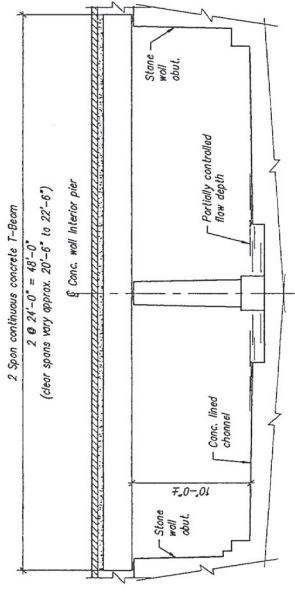


SECTION PARALLEL TO SECOND AVENUE

Looking East-Northeast

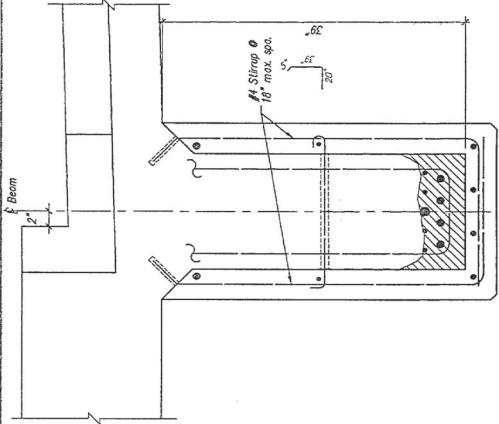

WEST BEAM
See East Beam for Details not Shown


SECTION @ INT. PIER
West Beam Shown
East Beam Similar

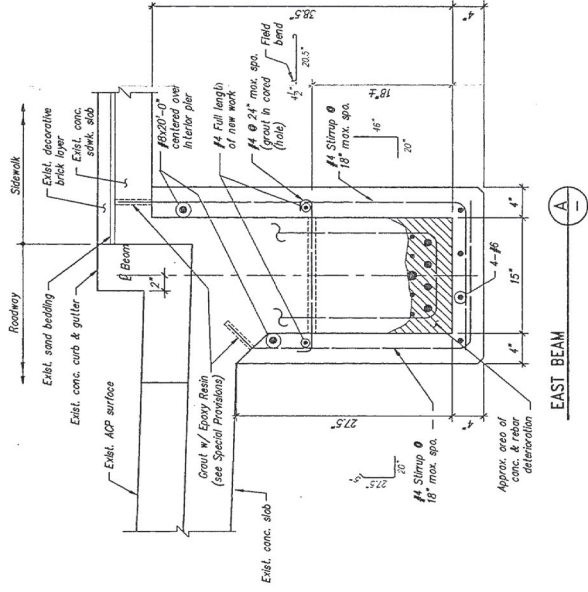

EAST BEAM


DESIGNED BY: C.E. Moynon	DATE	PLM CHECK	ISSUED:	DATE	NO.	REVISION	BY
CHECKED BY: W.A. Whitney							
DETAILED BY: J.E. Walsh							
FEDERAL AID PROJECT NO. BH-718X(00)							
PROJECT NO. PK 95-502							
SARGENT		SARGENT ENGINEERS, INC.		320 West Boy Drive, Suite 101 • Olympia, Washington 98502		Tel. 360 943-3390 • Fax 360 352-3581	
WALLA WALLA DEPARTMENT OF PUBLIC WORKS		SECOND AVENUE BRIDGE REHABILITATION		City of Walla Walla, Washington		SECTIONS & DETAILS	
ENGINEER		DATE		PROJECT NO.		SHEET 2 OF 3	
DRAWN		DATE		PROJECT NO.		SHEET 2 OF 3	
CHECKED		DATE		PROJECT NO.		SHEET 2 OF 3	
APPROVED		DATE		PROJECT NO.		SHEET 2 OF 3	

33'-3" Normal to Main St.
 4'-0" Normal to Main St.
 34'-0" Normal to Main St.
 34'-0" Normal to Main St.

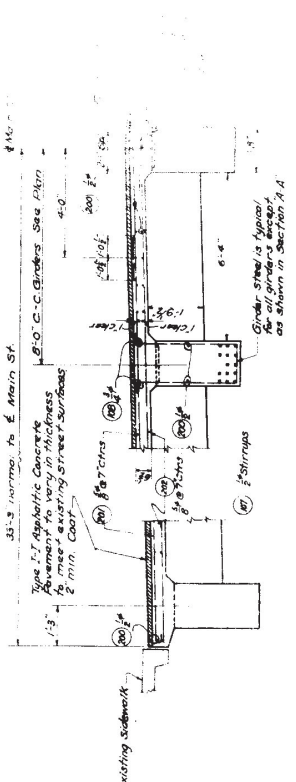


TYPICAL RDWY SECTION - SECTION B-B


34'-0" Normal to Main St.
 34'-0" Normal to Main St.
 34'-0" Normal to Main St.
 34'-0" Normal to Main St.

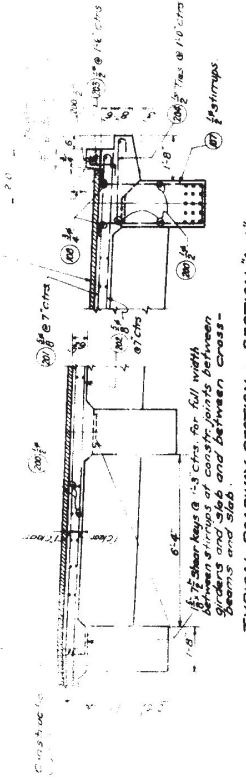

TYPICAL RDWY SECTION - SECTION A-A

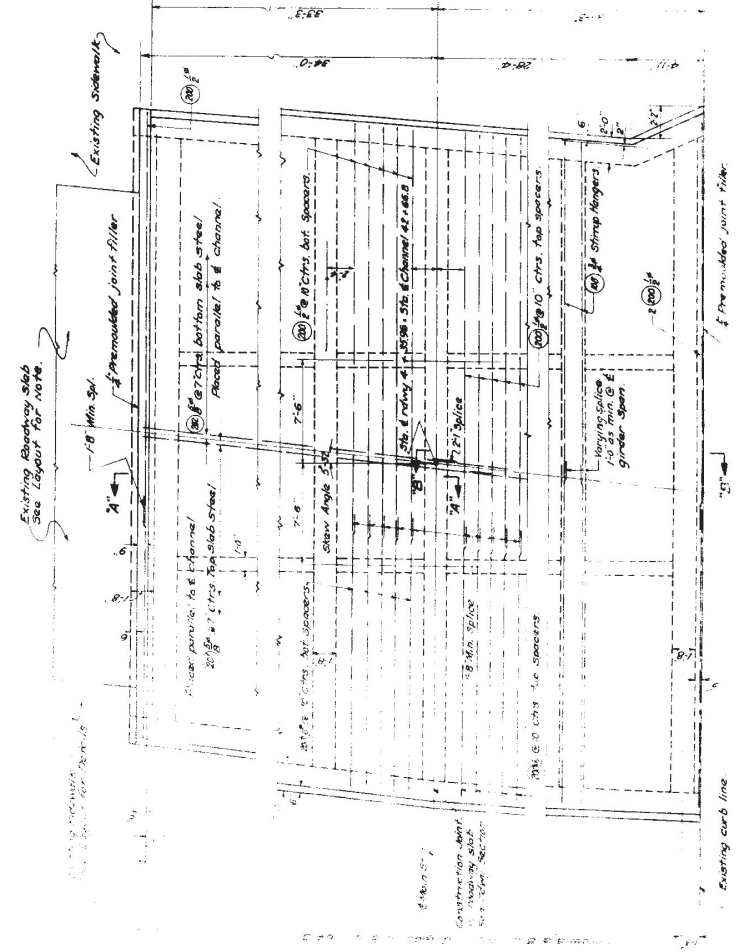

PLAN

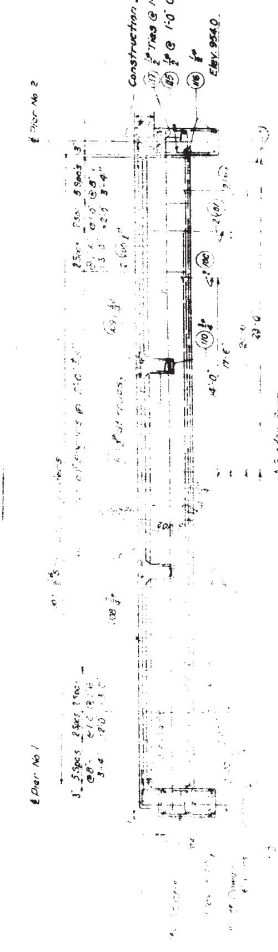


TYPICAL SECTION THRU END WALL

PRIMARY STATE HIGHWAY NO. 3
 MILL CREEK BRIDGE NO. 3 606 S
 IN WALLA WALLA
 WALLA WALLA COUNTY


PLAN & SECTIONS




2565

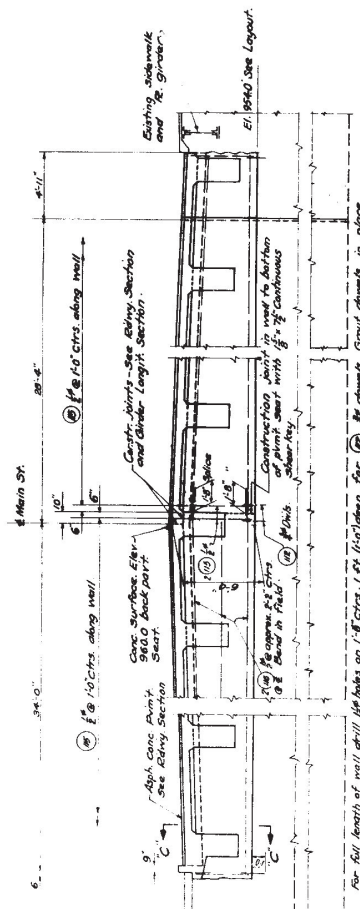


SECTION NEAR PIER NO. 2

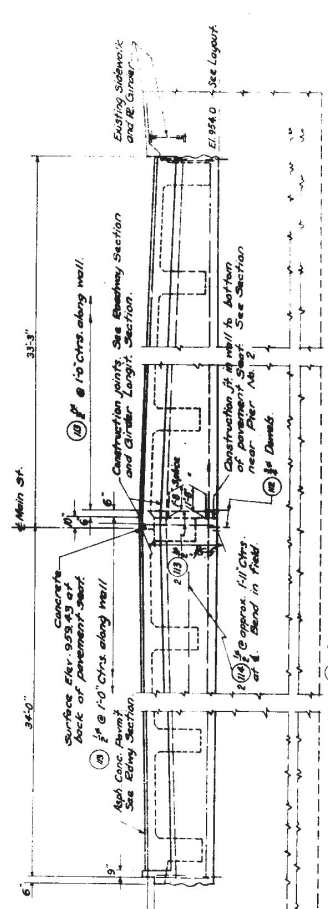

SECTION NEAR PIER NO. 1

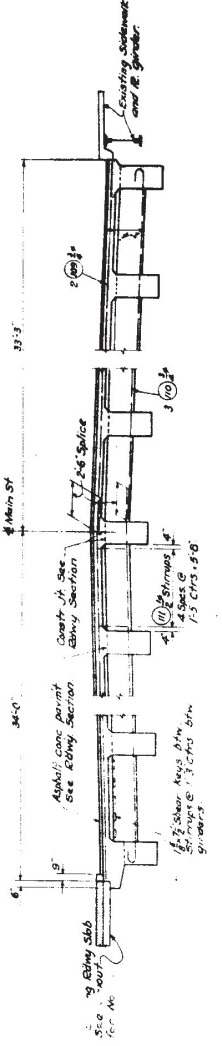

SECTION NEAR CROSS BEAM

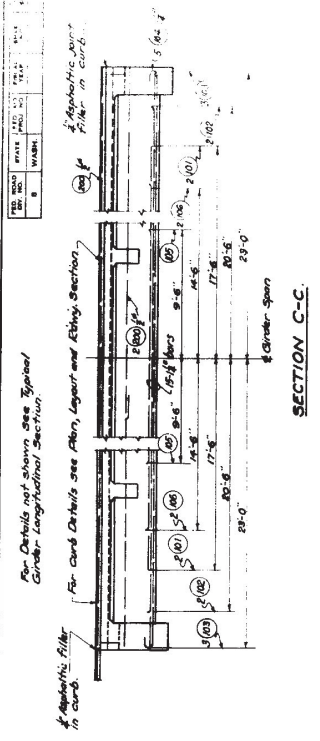

SECTION C-C

BAR LIST
All dimensions are out to out.

NO.	LOCATION	NO.	SIZE	LENGTH	BENDING DIAGRAM
100	GIRDER CROSS BEAMS and END WALLS	10	1/2"	15'-0"	(10)
101	Left End Girder	10	1/2"	15'-0"	(10)
102	Right End Girder	10	1/2"	15'-0"	(10)
103	Left End Girder	10	1/2"	15'-0"	(10)
104	Right End Girder	10	1/2"	15'-0"	(10)
105	Left End Girder	10	1/2"	15'-0"	(10)
106	Right End Girder	10	1/2"	15'-0"	(10)
107	Left End Girder	10	1/2"	15'-0"	(10)
108	Right End Girder	10	1/2"	15'-0"	(10)
109	Bottom Stirrups	10	1/2"	15'-0"	(10)
110	Top Stirrups	10	1/2"	15'-0"	(10)
111	End Wall Stirrups	10	1/2"	15'-0"	(10)
112	End Wall Vertical	10	1/2"	15'-0"	(10)
113	Pier No. 1 - Vertical	10	1/2"	15'-0"	(10)
114	Pier No. 2 - Vertical	10	1/2"	15'-0"	(10)
115	End Wall Vertical	10	1/2"	15'-0"	(10)
116	End Wall Vertical	10	1/2"	15'-0"	(10)
117	ROADWAY SLAB and CURB	10	1/2"	15'-0"	(10)
118	ROADWAY SLAB and CURB	10	1/2"	15'-0"	(10)
PRIMARY STATE HIGHWAY NO. 3
MILL CREEK BRIDGE NO. 3 606.5
IN WALLA WALLA
WALLA WALLA COUNTY



2 565

FED. ROAD DIV. NO.	STATE	FED. AID PROJECT NO.	FISCAL YEAR	SHEET NO.	TOTAL SHEETS
10	WASH.	BRM-7187(1)	1989	1	8

CITY OF WALLA WALLA, WASHINGTON
COLVILLE BRIDGE
P.W.E. 85-501

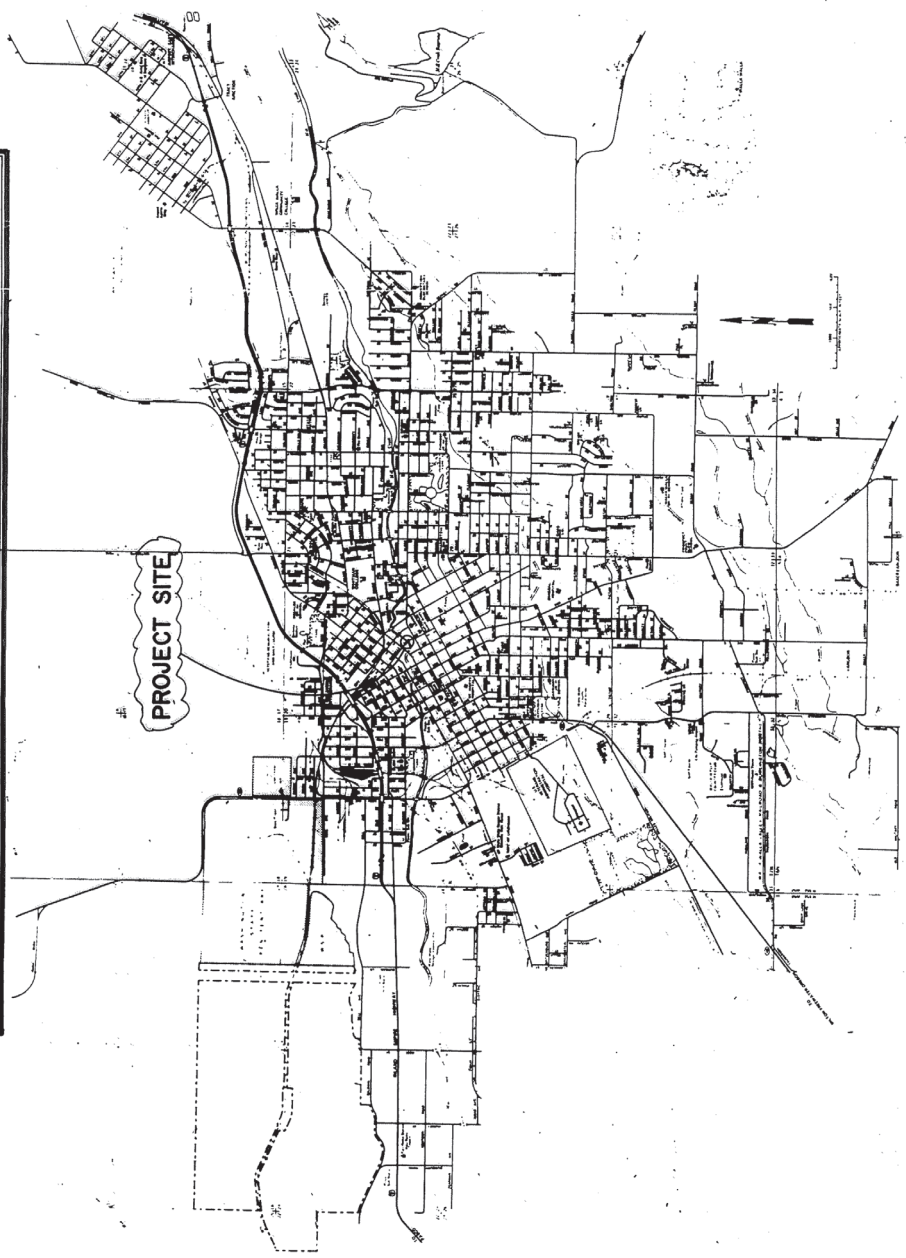

MAYOR
B. LOYAL SMITH
COUNCIL
ELLEN HAUN
MIKE JOHNSON
FRED MITCHELL
WILLIAM FLEENOR
TOM WILLIAMS
JOHN DAN SWANK
CITY MANAGER
HARRY D. KINZER
CITY ENGINEER
JACK MOLLSNESS, PE.



INDEX OF DRAWINGS	
NO.	DESCRIPTION
1	COVER SHEET, VICINITY MAP
2	SUMMARY OF QUANTITIES
3	LEGEND, GENERAL NOTES
4	PLAN & PROFILE
5	SLAB LAYOUT, WATERLINE CROSSING, & ABUT/PIER CAPS
6	SLAB DETAILS
7	PEDESTRIAN BARRIER DETAILS
8	HAND RAILING DETAILS

PROJECT NO. 85-501
COPY NO. _____
CONTRACTOR _____
COST _____

SUMMARY OF QUANTITIES

PROJECT LIMITS:
COLVILLE STREET

LENGTH: 250 L.F.

STA. 2+25 to STA. 4+75


ITEM NO.	TOTAL QUANTITY	UNIT	I T E M	GROUP 1	GROUP 2	SHEET NO.	TOTAL SHEETS
1	LUMP SUM	L.S.	PREPARATION	STA. 2+25		1	8
2	LUMP SUM	L.S.	MOBILIZATION 10-20-89, 8-15-89	STA. 3+25		2	
3	75	S.Y.	REMOVE PORTION OF EXISTING BRIDGE, COLVILLE BRIDGE 70% 8-15-89, 100% 8-22-89	TO STA. 4+75		2	
4	70	L.F.	REMOVE CEMENT CONCRETE SIDEWALK 10-30-89 = 48.85 yds ² 10-31-89 = 44.06 yds ²	(LESS BRIDGE)			
5	1	EA.	REMOVE CEMENT CONCRETE CURB AND GUTTER 10-30-89, 8-15-89	L.S.			
6	1110	S.Y.	REMOVE CONCRETE INLET 10-30-89, 1 ea.	75			
7	2	EA.	REMOVE EXISTING SUBGRADE AND PAVEMENT (60' (approx) X 40' (approx) Per boundary = 2400 sq ft)	100			
8	30	L.F.	UTILITIES = 266.67 yds, 8-15-89, Total 844.24 yds (Not including bridge)	1			
9	130	L.F.	CONCRETE INLET 10-30-89	1110			
10	LUMP SUM	L.S.	DUCTILE IRON PIPE FOR WATER MAIN, 8" DIA. (South) 10-12-89, (North) 10-30-89	2			
11	21	C.Y.	COLVILLE BRIDGE WATERLINE CROSSING 100' x 9-29-89	30			
12	12	C.Y.	STRUCTURE	L.S.			
13	3100	LBS.	STRUCTURE EXCAVATION CLASS A, INCLUDING HAUL South About 8-25-89				
14	28,200	LBS.	GRAVEL BUCKETILL FOR WALL 11 1/2 S = 10-17-89 North About 9-9-89				
15	150	C.Y.	EPXY-COATED STEEL REINFORCING BAR				
16	30	C.Y.	STEEL REINFORCING BAR A1065 & Pier Caps = 2439.82 lbs, 9-27-89				
17	18	C.Y.	CONCRETE CLASS 'AX' FOR SLAB				
18	86	C.Y.	CONCRETE CLASS 'AX' FOR BRIDGE SIDEWALK 10-30-89				
19	86	L.F.	CONCRETE CLASS 'AX' FOR ABUTMENT/PIER CAPS 2102 yds, 9-27-89				
20	55	S.Y.	PEDESTRIAN BARRIER 10-30-89				
21	105	TON	HAND RAILING 11-6-89				
22	225	TON	EXPOSED AGGREGATE FINISH 11-9-89				
23	210	TON	STREET				
24	2	EA.	CRUSHED SURFACING TOP COURSE				
25	70	L.F.	ASPHALT TREATED BASE INCLUDING PAVING ASPHALT 11-1-89				
26	90	S.F.	ASPHALT CONCRETE PAVEMENT INCLUDING PAVING ASPHALT 11-3-89				
27	10	EA.	OTHER				
28	75	S.Y.	GATE VALVE, 8" (South) 10-17-89, (North) 10-30-89				
29	3	L.F.	CEMENT CONCRETE CURB AND GUTTER 10-30-89				
			TEMPORARY SIGNING 8-15-89				
			TYPE III BARRICADE 8-15-89				
			CEMENT CONCRETE SIDEWALK 10-30-89				
			CHAIN LINK FENCE, TYPE 6 11-6-89				
			MOB. Water Stop 10-2-89				
			MOB. Re-bar 10-2-89				
			# Bdy. Bridge Support Joints				

NOTE: For special features see special provisions.

CITY OF WALLA WALLA
ENGINEERING DIVISION
COLVILLE BRIDGE
SUMMARY OF QUANTITIES



CDR. ROAD DIST. NO.	10
STATE PROJ. NO.	WASH. DCAM-7187(D)
FISCAL YEAR	1989
SHEET NO.	4
TOTAL SHEETS	8

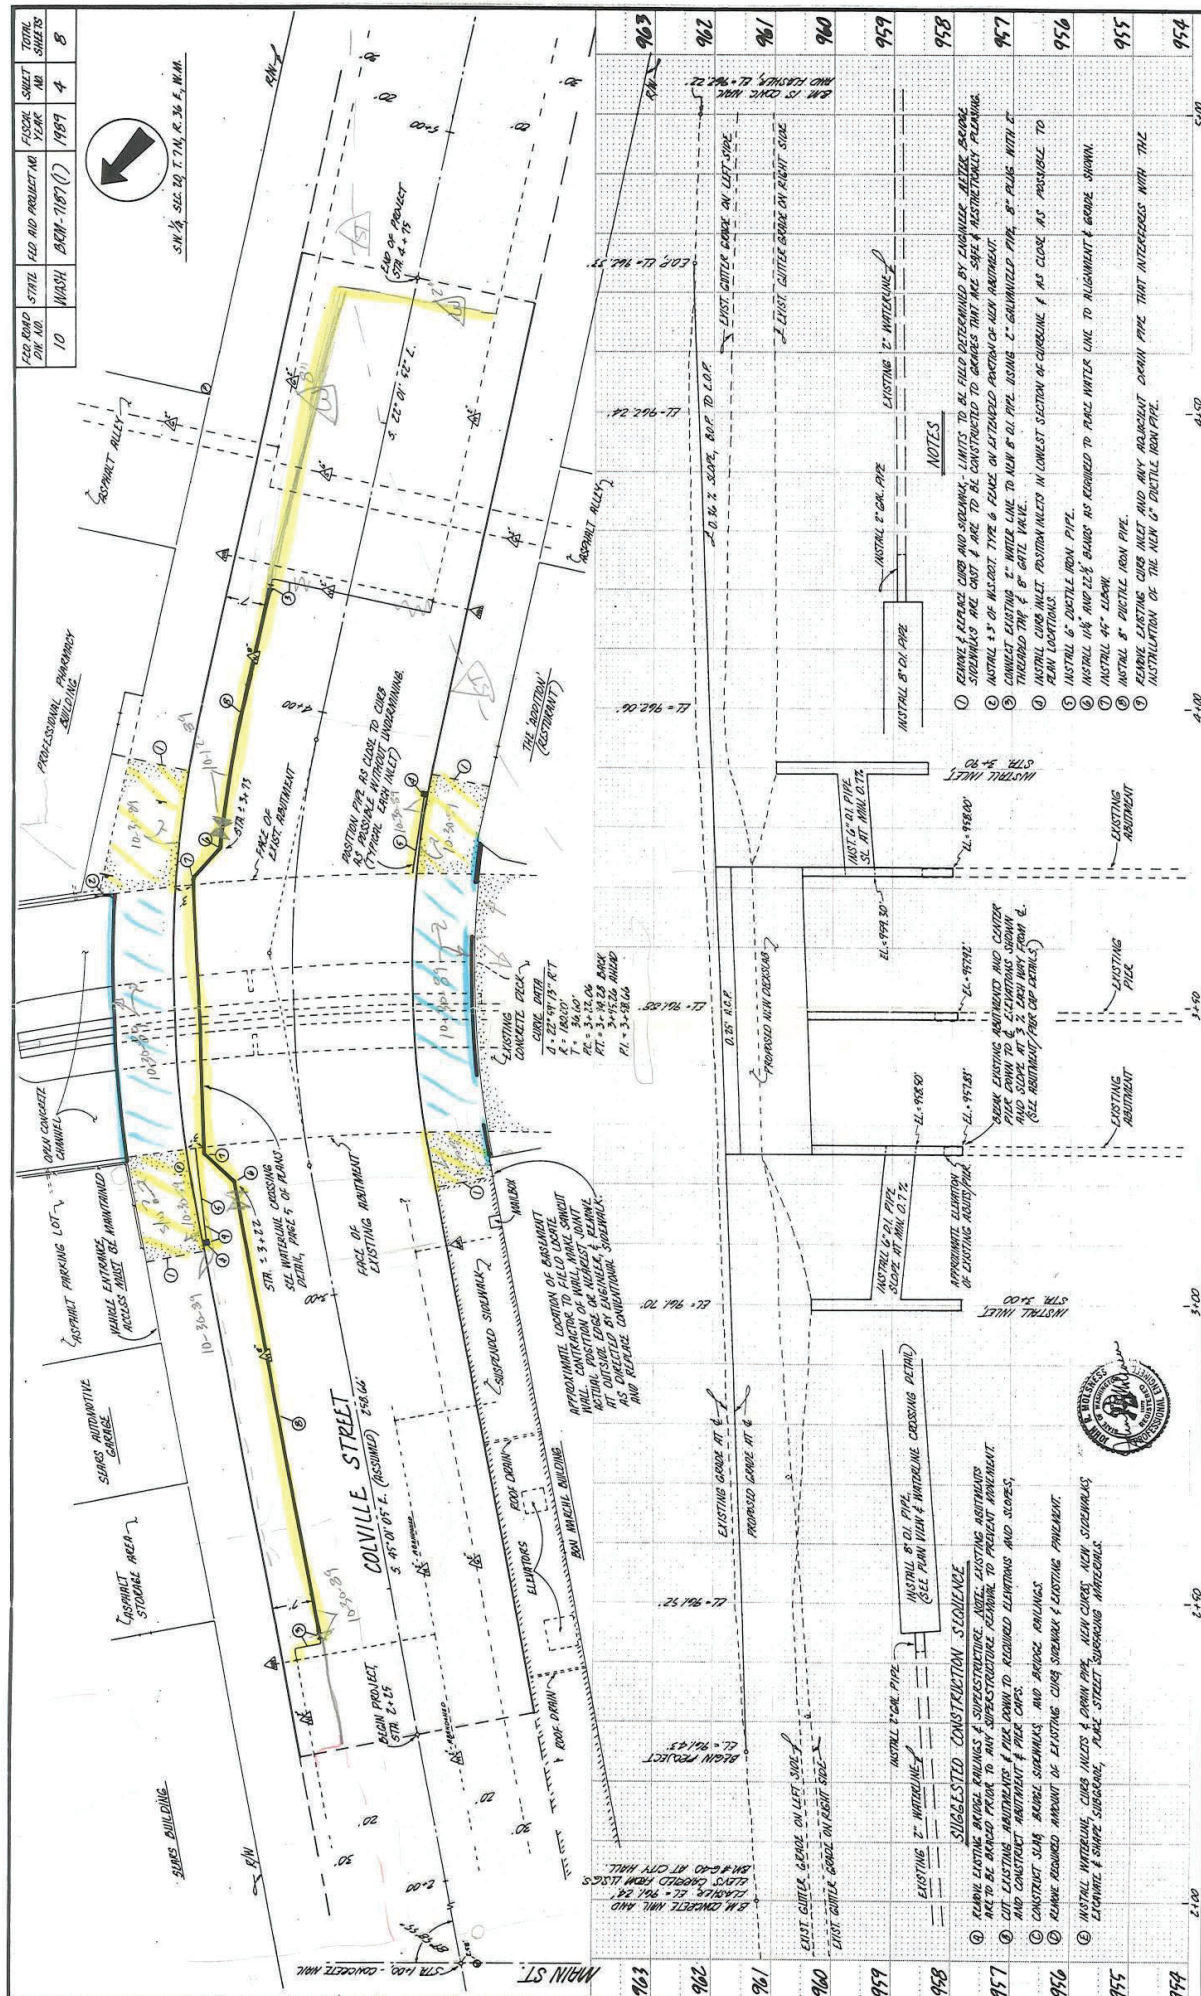

- NOTES**
- REMOVE & REPLACE CURB AND SIDEWALKS - LIMITS TO BE FULFILLED DETERMINED BY EXISTING UTILITY DEPTH. SIDEWALKS ARE NOT TO BE CONSTRUCTED TO GRADES THAT ARE SAFE & AESTHETICALLY PLEASANT.
 - INSTALL 4" OF INLEAK-TYPE & PLACE ON EXTENDED PORTION OF NEW ALIGNMENT.
 - CONSTRUCT EXISTING 2" WATER LINE TO NEW 8" DI. PIPE USING 2" GALVANIZED PIPE 8" FLANG WITH 2" THROUGH-TAP & 8" GATE VALVE.
 - INSTALL CURB INLET POSITION IN LOWEST SECTION OF CURBLINE AS CLOSE AS POSSIBLE TO MAIN ALIGNMENT.
 - INSTALL 8" DUCTILE IRON PIPE.
 - INSTALL 18" AND 24" BARS AS REQUIRED TO PLACE WATER LINE TO ALIGNMENT & GRADE SHOWN.
 - INSTALL 8" DUCTILE IRON PIPE.
 - REMOVE EXISTING CURB INLET AND ANY ADJACENT DRAIN PIPE THAT INTERFERES WITH THE INSTALLATION OF THE NEW 8" DUCTILE IRON PIPE.

NO.	2+00	2+50	3+00	3+50	4+00	4+50	5+00
REVISION							
BY	DATE	DATE	DATE	DATE	DATE	DATE	DATE
CHECKED							
APPROVED							
AS BUILT	REVISION	REVISION	REVISION	REVISION	REVISION	REVISION	REVISION
DATE	DATE	DATE	DATE	DATE	DATE	DATE	DATE
SCALE	SCALE	SCALE	SCALE	SCALE	SCALE	SCALE	SCALE
FILE NO.	FILE NO.	FILE NO.	FILE NO.	FILE NO.	FILE NO.	FILE NO.	FILE NO.

CITY OF WALLA WALLA
PUBLIC WORKS / ENGINEERING
WALLA WALLA, WASHINGTON 99368

PLAN & PROFILE

COLVILLE BRIDGE



PROJECT NO. 10
 SHEET NO. 4
 DATE: 1989
 SCALE: 1" = 20' PLAN, 1" = 10' PROFILE
 FILE NO.

3 6519

OTIS STREET BRIDGE

CROSSING MILL CREEK








WALLA WALLA

WASH.

JUNE 1923

W. R. REHORN
CITY ENGR.

SCALE 1/4" = 1'

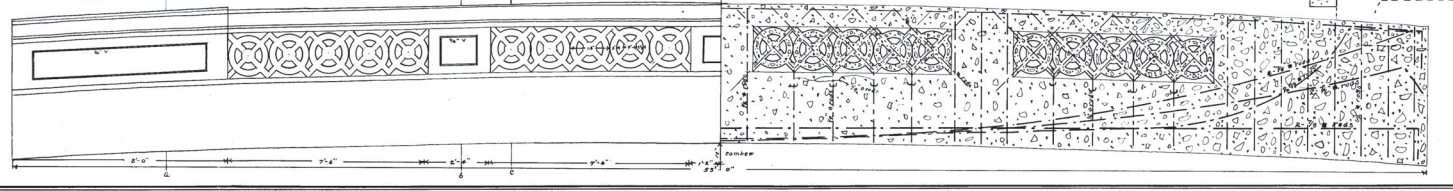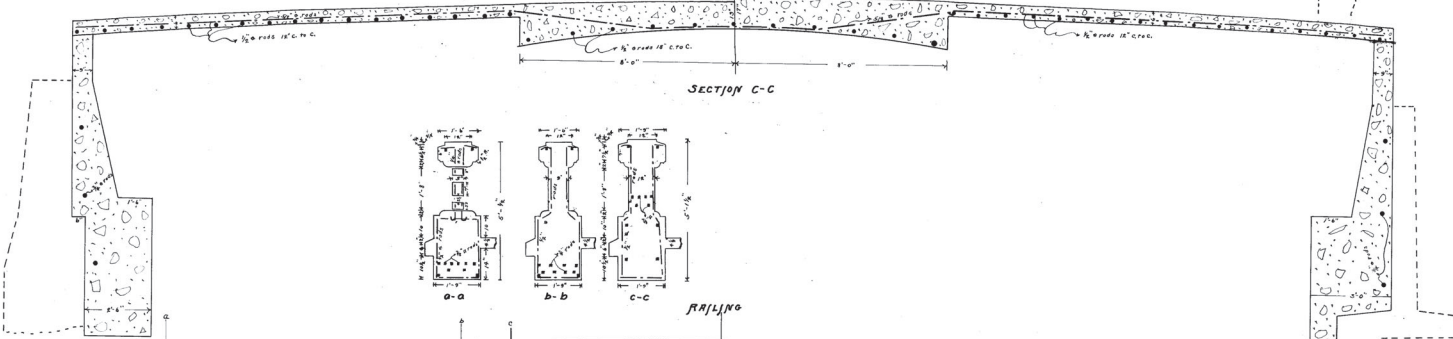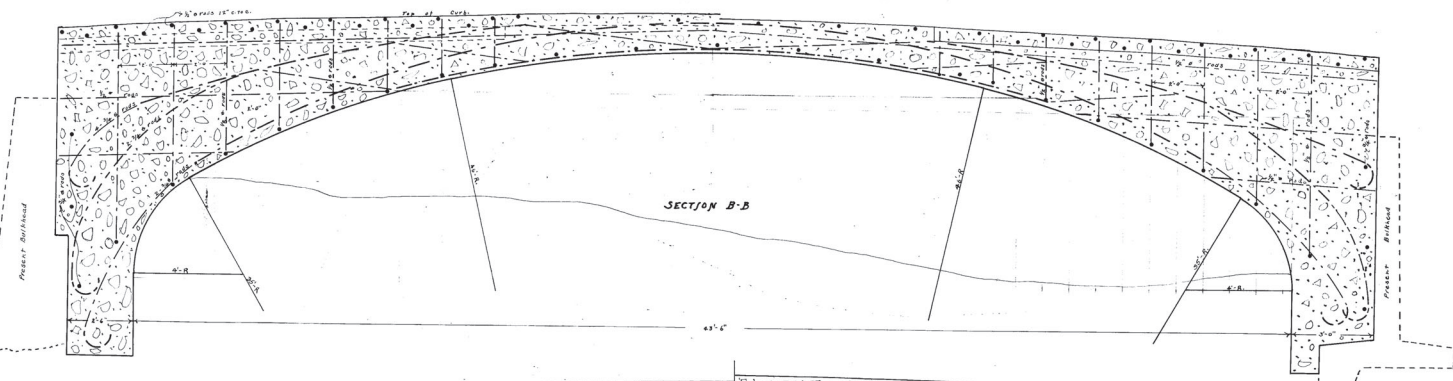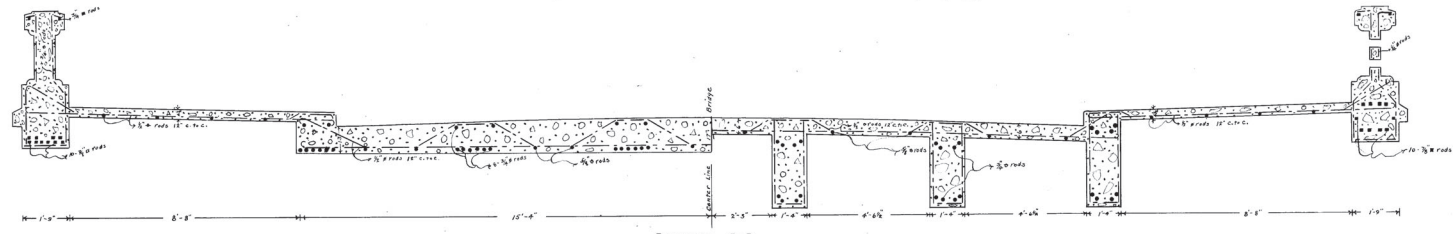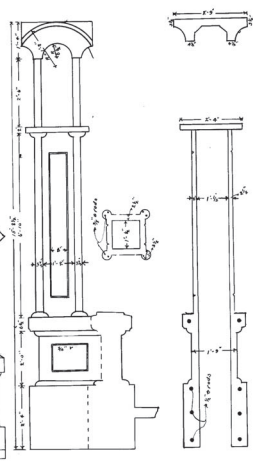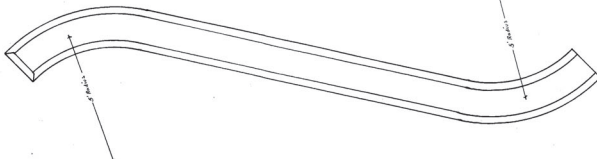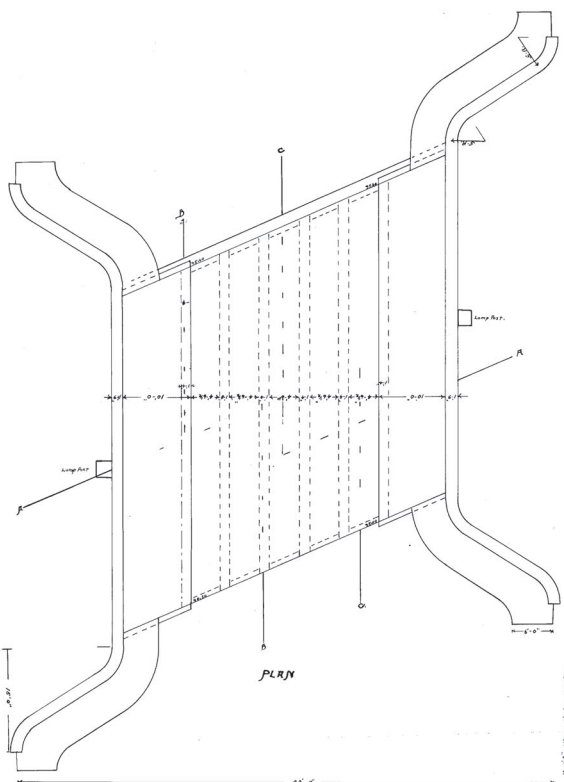

MERRIAM STREET BRIDGE

CROSSING MILL CREEK









WALLA WALLA

WASH

SCALE 1/8" = 1'

MAY 1924

W. R. Rehner
CITY ENGINEER

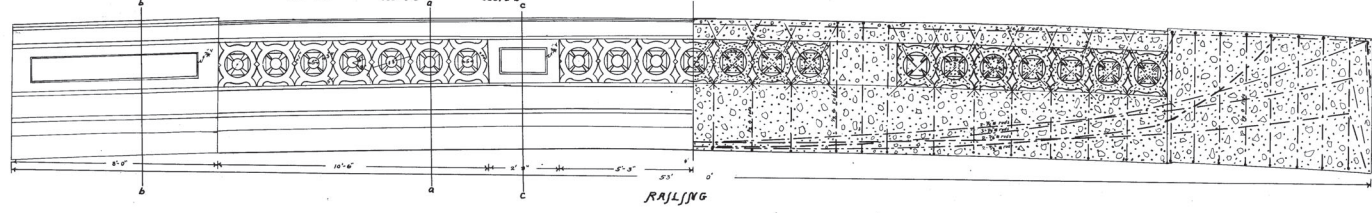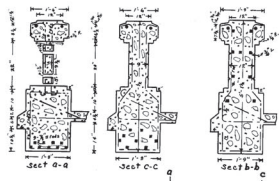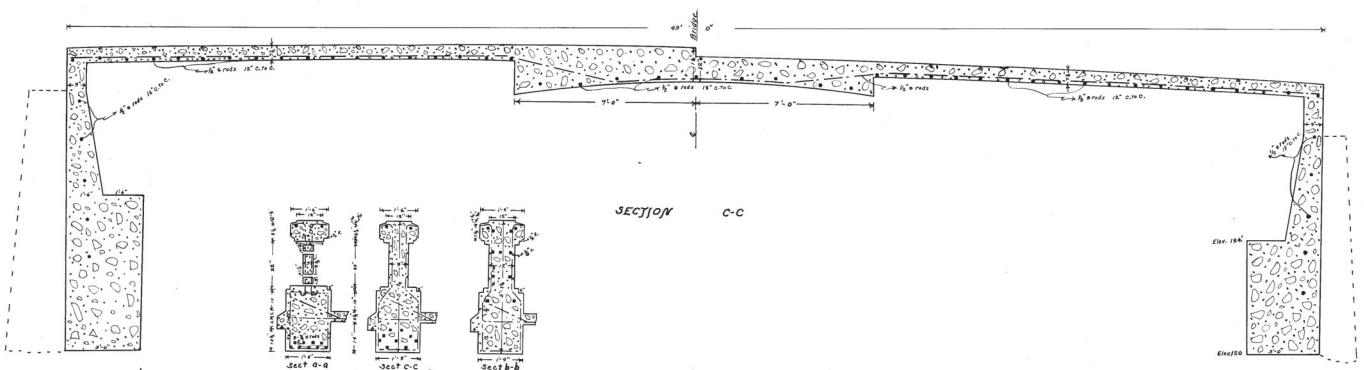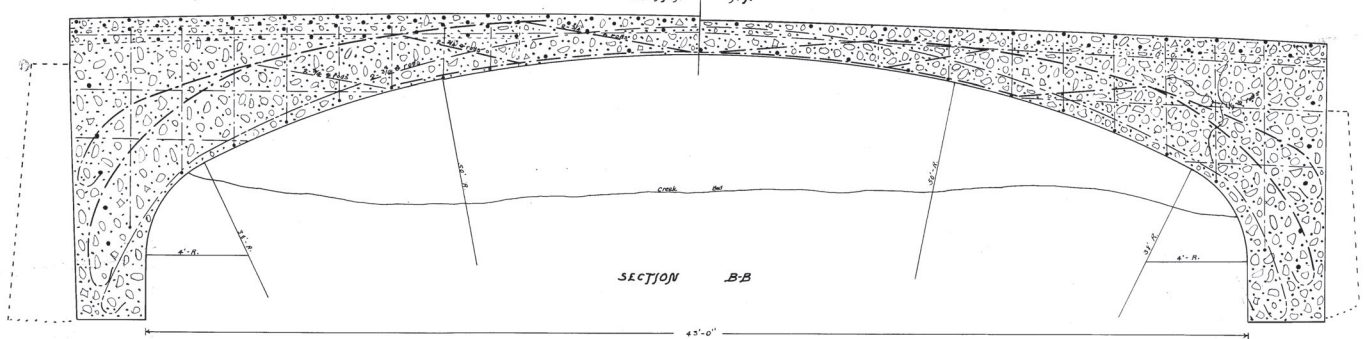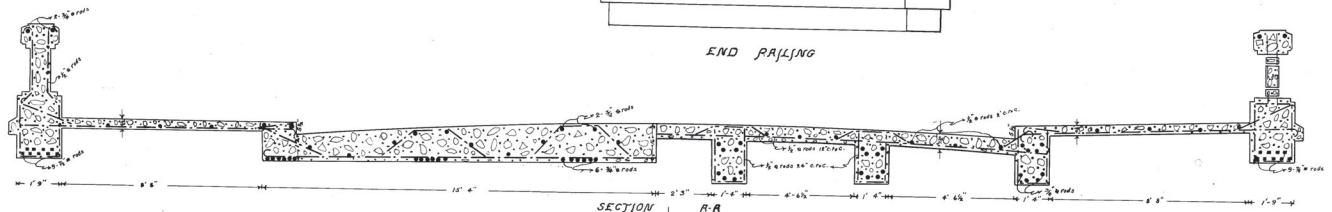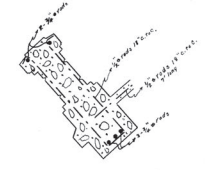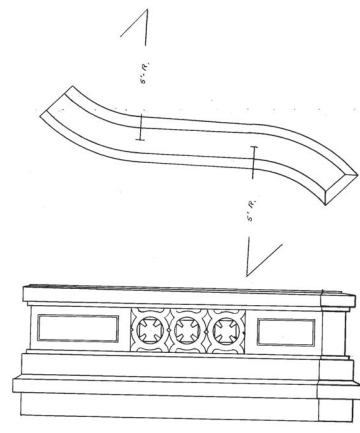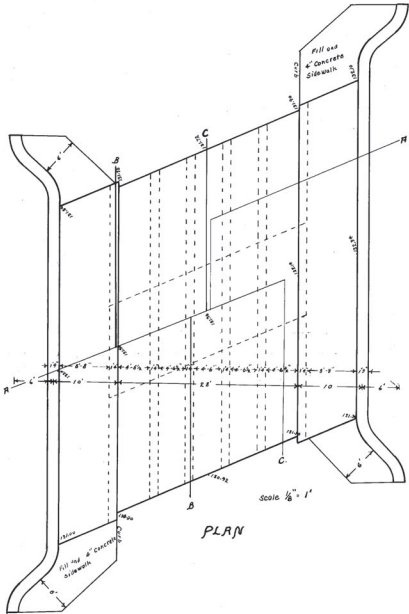




CLINTON STREET BRIDGE

CROSSING MILL CREEK



1922

WALLAWILLA WASH


Designed by
W. R. R. L. & Co.
City Engrs.

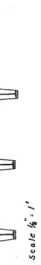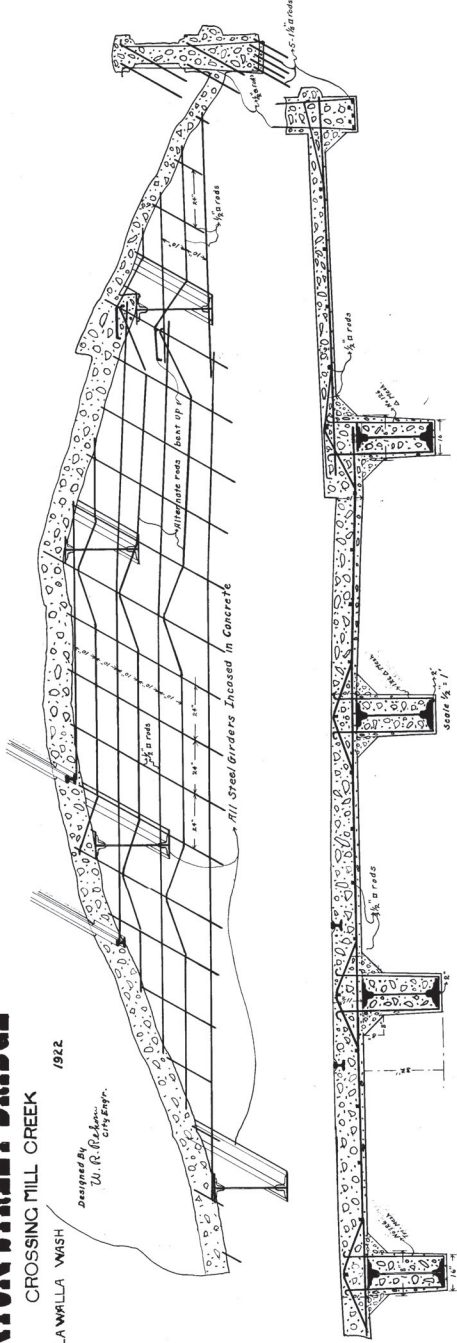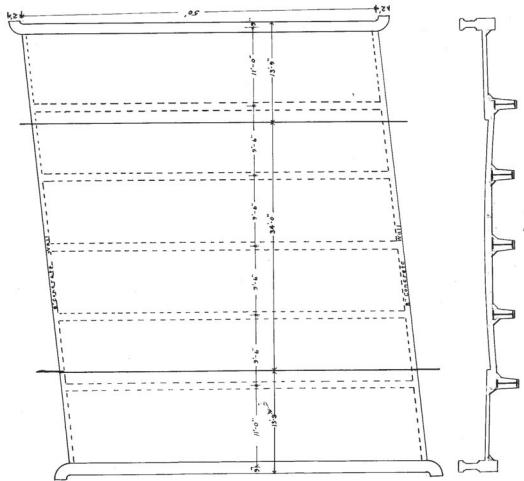

Scale 1/2" = 1'

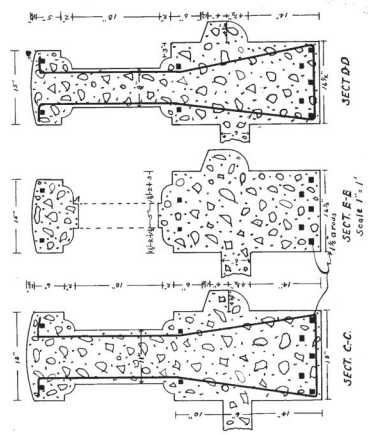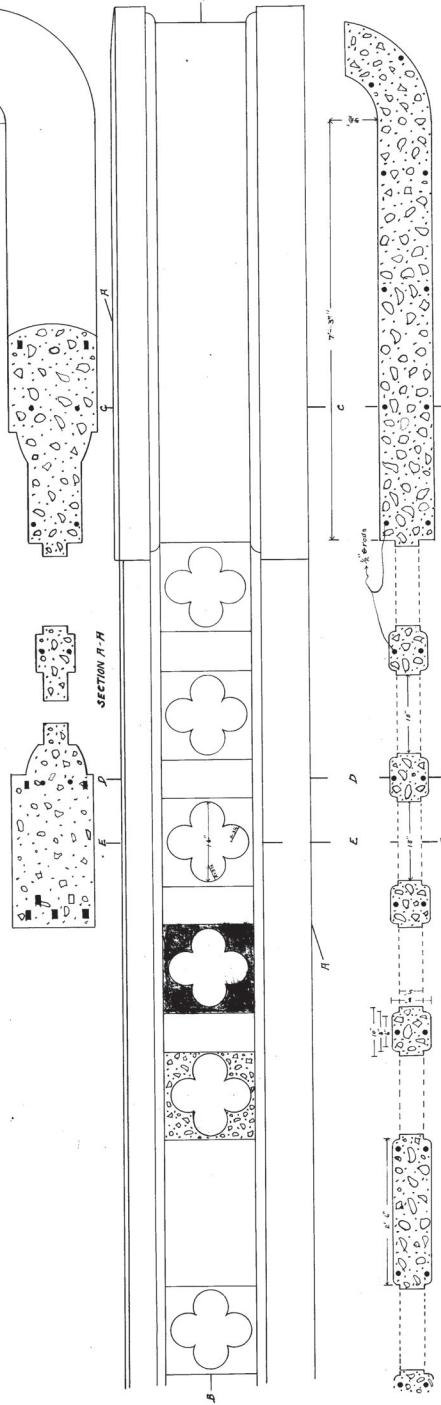

8100

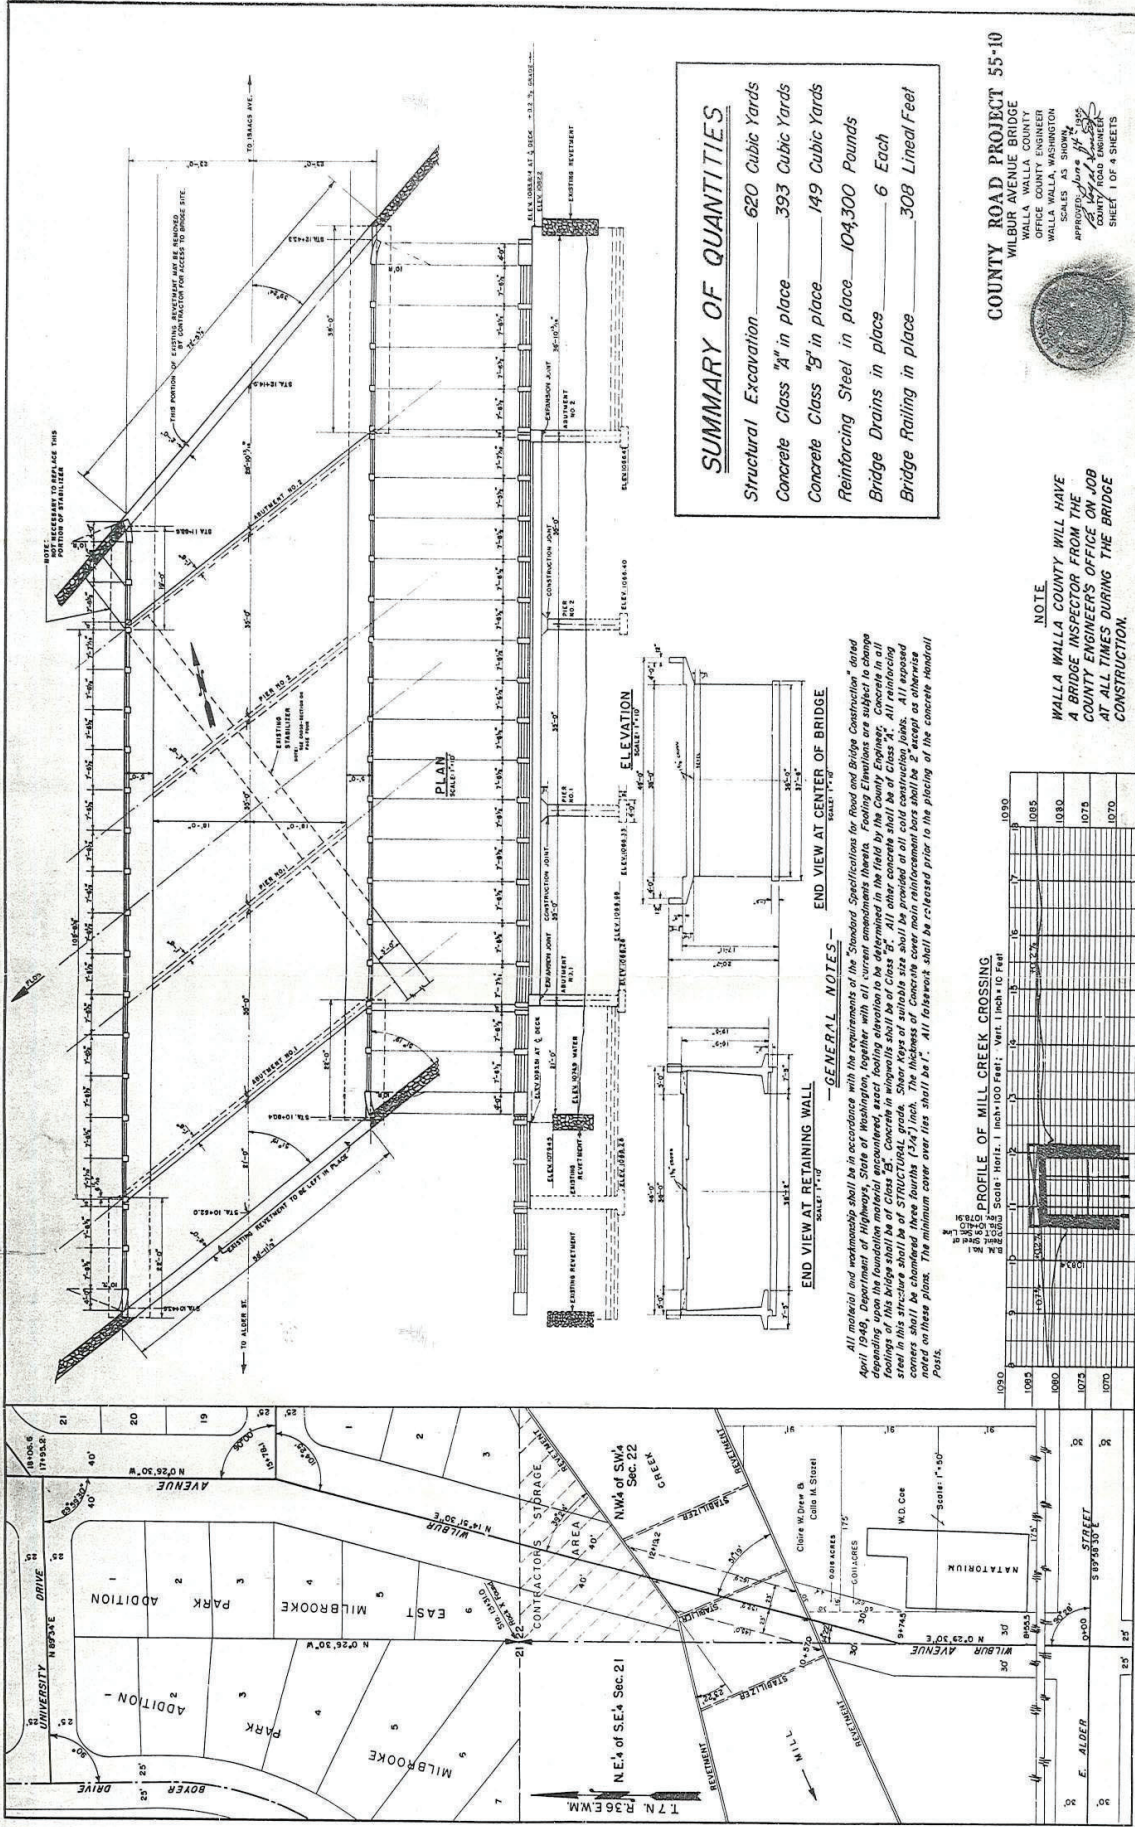

SUMMARY OF QUANTITIES


Structural Excavation	620 Cubic Yards
Concrete Class "A" in place	393 Cubic Yards
Concrete Class "B" in place	149 Cubic Yards
Reinforcing Steel in place	104,300 Pounds
Bridge Drains in place	6 Each
Bridge Railing in place	308 Lined Feet

COUNTY ROAD PROJECT 55-10
 WILBUR AVENUE BRIDGE
 WALLA WALLA COUNTY
 OFFICE COUNTY ENGINEER
 WALLA WALLA, WASHINGTON
 DRAWN BY: J. H. HARRIS
 APPROVED: J. H. HARRIS
 AT ALL TIMES DURING THE BRIDGE CONSTRUCTION.




NOTE
 WALLA WALLA COUNTY WILL HAVE
 A BRIDGE INSPECTOR FROM THE
 COUNTY ENGINEER'S OFFICE ON JOB
 AT ALL TIMES DURING THE BRIDGE
 CONSTRUCTION.

GENERAL NOTES
 All material and workmanship shall be in accordance with the requirements of the "Standard Specifications for Road and Bridge Construction" dated April 1949, Department of Highways, State of Washington, together with all current amendments thereto. Tolerances are subject to change. Footings of this bridge shall be of Class "B". Concrete in wingwalls shall be of Class "B". All other concrete shall be Class "A". All reinforcing steel in this structure shall be of STRUCTURAL grade. Shear Keys of suitable size shall be provided at all cold construction joints. All exposed corners shall be chamfered three fourths (3/4) inch. The thickness of concrete cover main reinforcement bars shall be 2" except as otherwise noted on these plans. The minimum cover over ties shall be 1". All tolerances shall be released prior to the placing of the concrete handrail posts.

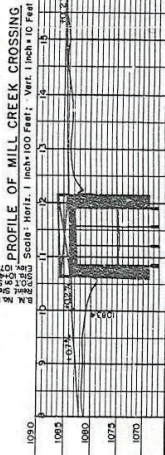


DATE	BY	REVISION
11/15/50	J.H.H.	1
11/15/50	J.H.H.	2
11/15/50	J.H.H.	3
11/15/50	J.H.H.	4
11/15/50	J.H.H.	5
11/15/50	J.H.H.	6
11/15/50	J.H.H.	7
11/15/50	J.H.H.	8
11/15/50	J.H.H.	9
11/15/50	J.H.H.	10

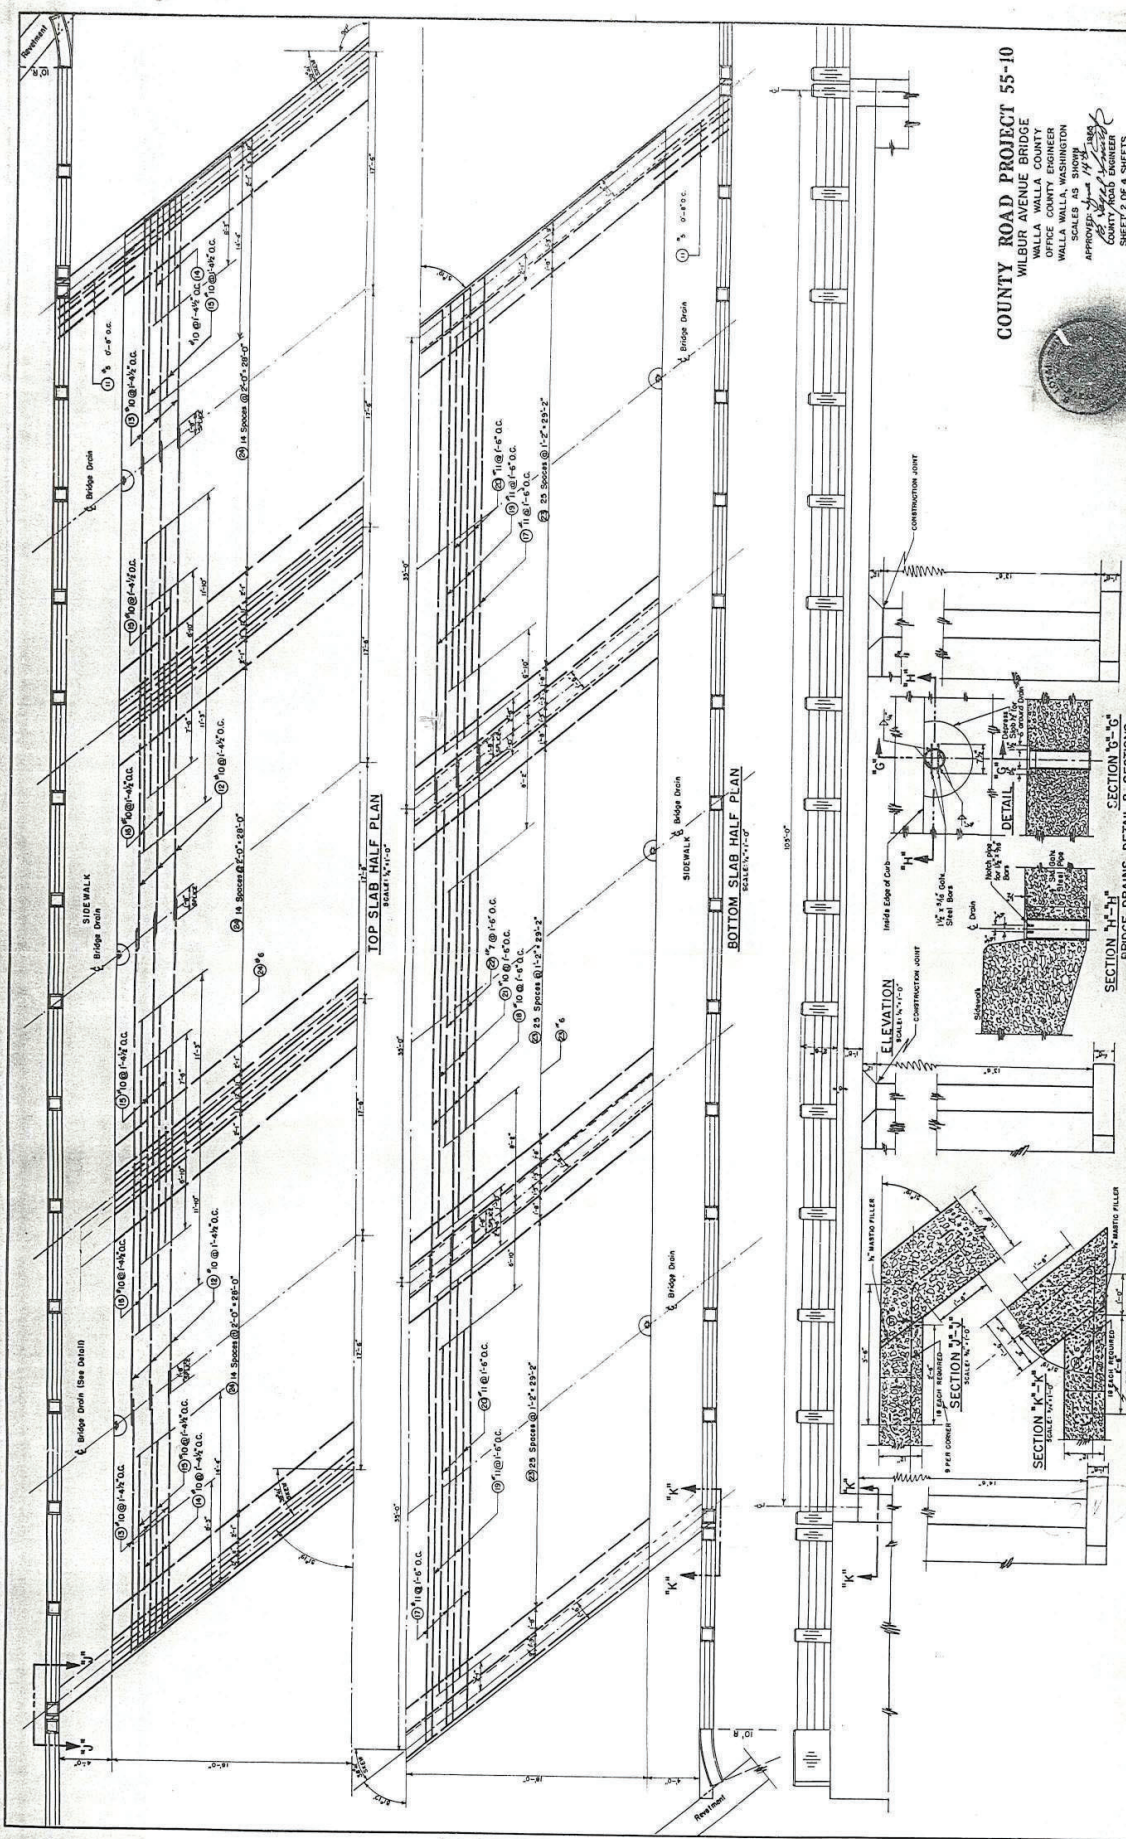

COUNTY ROAD PROJECT 55-10
 WILBUR AVENUE BRIDGE
 WALLA WALLA COUNTY
 WALLA WALLA, WASHINGTON
 APPROXIMATELY 1928
 COUNTY ROAD ENGINEER
 SHEET 2 OF 4 SHEETS



DATE	BY	DESCRIPTION
10/1/58	W.A.J.	DESIGNED
10/1/58	W.A.J.	DRAWN
10/1/58	W.A.J.	CHECKED

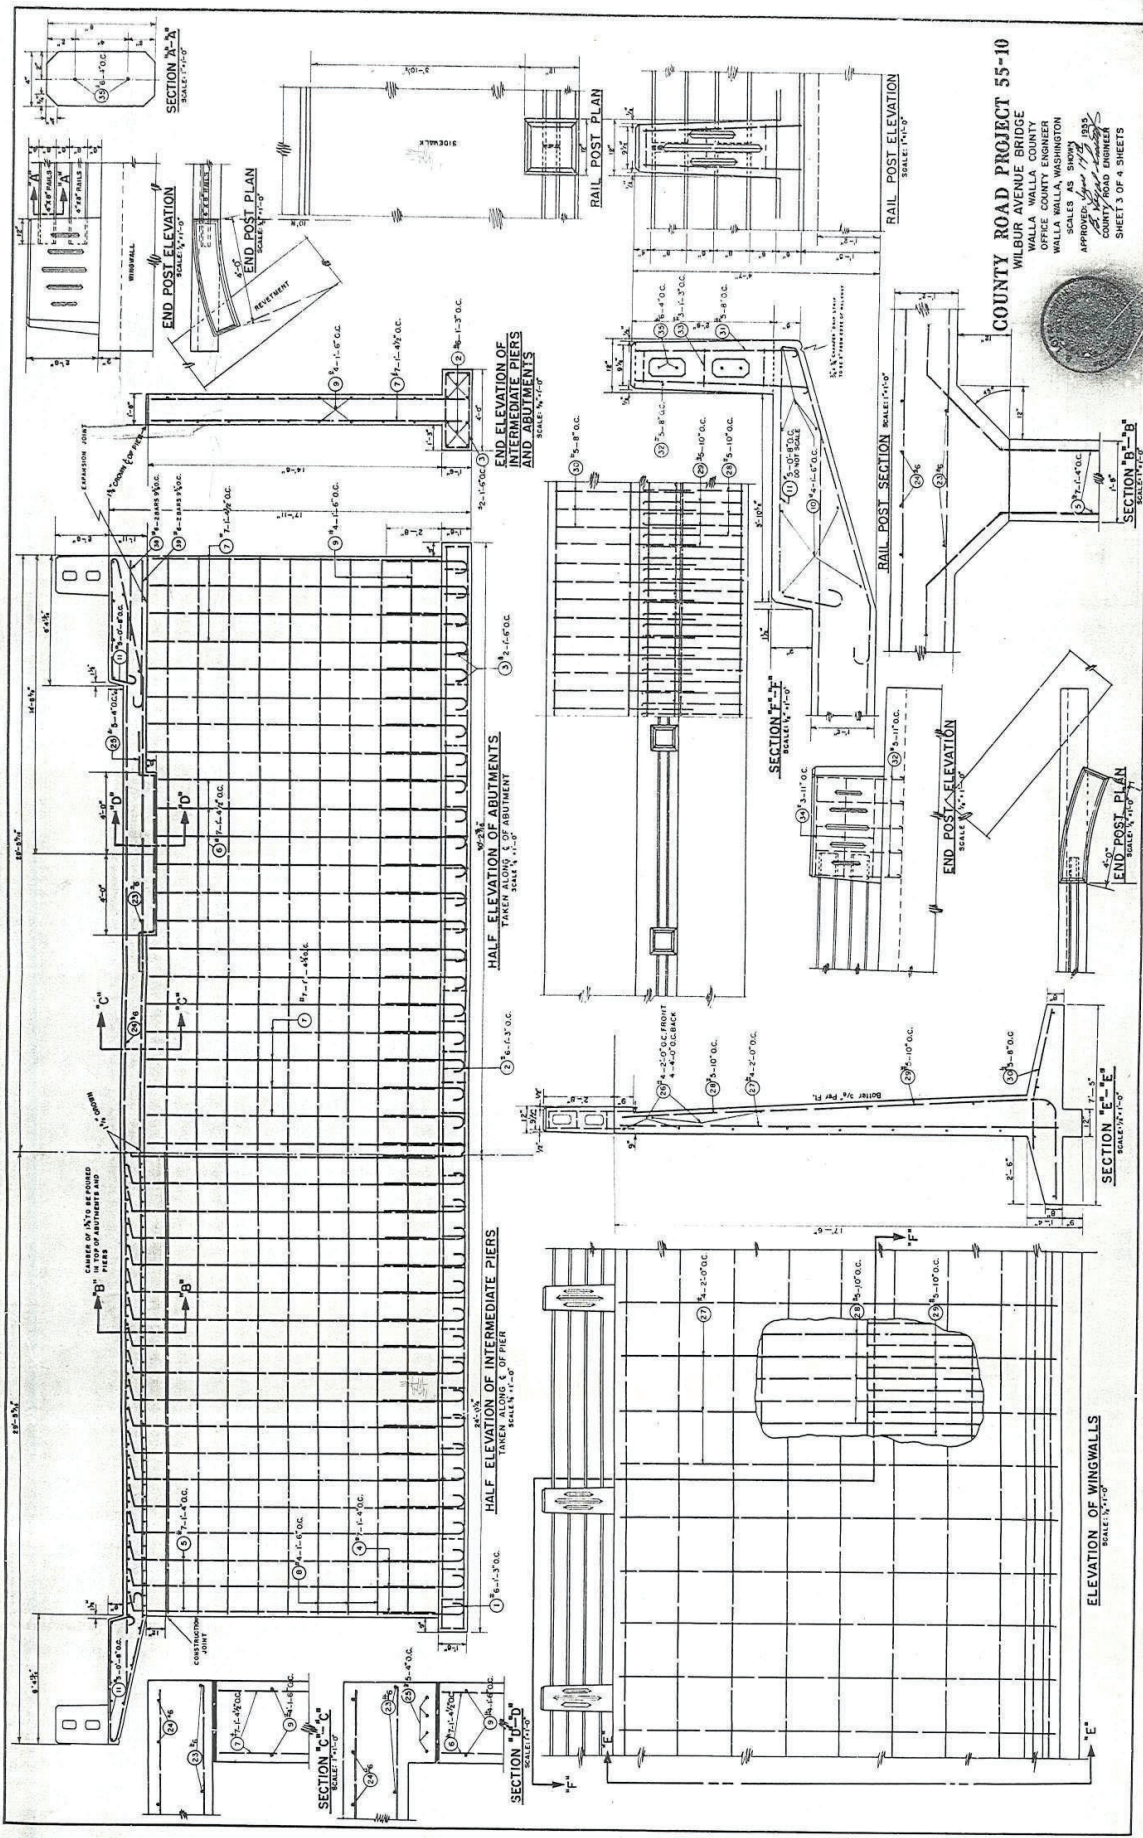

COUNTY ROAD PROJECT 55-10
 WILBUR AVENUE BRIDGE
 WALLA WALLA COUNTY
 OFFICE COUNTY ENGINEER
 WALLA WALLA, WASHINGTON
 SCALE AS SHOWN
 APPROVED: [Signature]
 COUNTY ROAD ENGINEER






DATE	BY	DESCRIPTION
11-1-55	R.M. M.	PREPARED
11-1-55	R.M. M.	TRACED
11-1-55	R.M. M.	CHECKED
11-1-55	R.M. M.	APPROVED

BAR LIST

MARK	LOCATION	NO.	SIZE	LENGTH
1	Intermediate Pier Footings	32	#6	20'-1"
2	End Pier Footings	48	#6	21'-0"
3	Footings	148	#6	10'-6"
4	Footings	316	#6	4'-10"
5	Intermediate Abutment	140	#6	16'-4"
6	End Vertical Abutment	48	#6	13'-0"
7	End Vertical Abutment	128	#6	14'-4"
8	Horizontal Spacers	72	#6	23'-1"
9	Horizontal Spacers	108	#6	20'-9"
10	Sidewalk and Curb	56	#4	27'-10"
11	Sidewalk Hoops	319	#5	14'-1"
12	Top Slab Deck	56	#10	36'-8"
13	Top Slab Deck	56	#10	18'-2"
14	Top Slab Deck	52	#10	8'-3"
15	Top Slab Deck	108	#10	14'-4"
16	Top Slab Deck	54	#10	23'-1"
17	Bottom Slab Deck	52	#11	36'-7"
18	Bottom Slab Deck	26	#10	36'-8"
19	Bottom Slab Deck	50	#11	33'-3"
20	Bottom Slab Deck	50	#11	26'-1"
21	Bottom Slab Deck	25	#10	34'-4"
22	Bottom Slab Deck	23	#7	18'-8"
23	Bottom Slab Deck	172	#6	24'-3"
24	Top Slab Deck	118	#6	27'-7"
25	End Pier Key Bars	16	#5	13'-8"
25-1	Reinforcing Wall Horizontal	34	#4	21'-8"
25-2	Reinforcing Wall Horizontal	51	#4	18'-0"
27	Reinforcing Wall Vertical	51	#4	16'-5"
28	Reinforcing Wall Vertical	121	#5	19'-1"
29	Reinforcing Wall Vertical	121	#5	10'-9"
30	Reinforcing Wall Horizontal	182	#5	8'-3"
31	Guard Rail Post Vertical	60	#5	3'-7"
32	Guard Rail Post Vertical	140	#5	5'-10"
33	Guard Rail Post Hoops	120	#5	3'-4"
34	End Guard Rail Post	12	#5	9'-10"
35	Guard Rails	182	#6	7'-5"
36	Wingspan Abutment Ties	18	#8	7'-3"

MARK	LOCATION	NO.	SIZE	LENGTH
37	Wingspan Abutment Ties	18	#8	7'-3"
38	Sidewalk Abutment Deck	8	#6	3'-1"
39	Sidewalk Abutment Deck	8	#6	8'-9"

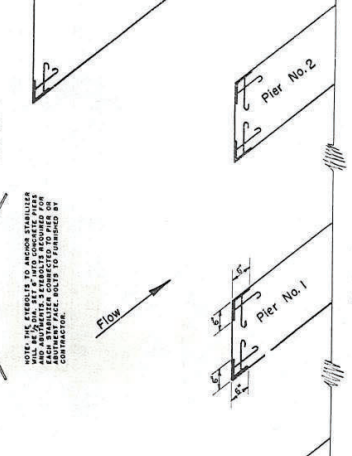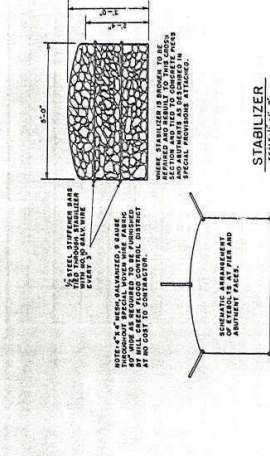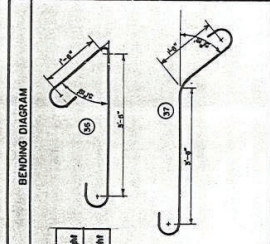

NOTE: #4 x 6'-6" Steel Column Shields will be welded as required to fit the 6 exposed corners of the supports, 106 sq. ft. of shields, and Pier No. 2. Said steel to be made 9' long and anchored with 8 #4 x 12" long bolts welded to each shield. Said shields to be furnished by Construction Co. at incidental expense to Concrete Class 70. No pay item authorized for said shields. Top end of shield to be extended to construction joint.

Standard Date Panel To Be Placed At Center of Inside Face of Right Hand End Post For Approaching Traffic At Each Pier. Date Panel To Be Placed At Center of the other Two End Posts To Be Placed With No Direction. Date Panels To Be Furnished By Walla Walla County.

SEQUENCE OF POURING CONCRETE

1. Footings
2. Pier No. 1 and Pier No. 2 to Construction Joint
3. Abutment No. 1 and Abutment No. 2 to Expansion Joint
4. Deck, Curb and Sidewalk
5. Wingspan Footings
6. Wingspan
7. Handrail Posts


NOTE: Deck to be One Continuous Pour

COUNTY ROAD PROJECT 55-10

WILBUR AVENUE BRIDGE
 WALLA WALLA COUNTY ENGINEER
 WALLA WALLA, WASHINGTON
 APPROVED: [Signature]
 COUNTY ROAD ENGINEER
 SHEET 4 OF 4 SHEETS




REGION NO.	STATE	FEDERAL AID PROJECT NUMBER	SHEET NO.	TOTAL SHEETS
16	WASH.	STPY-720000D	29	80

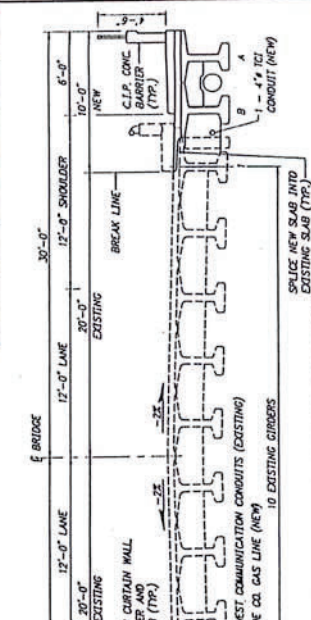

TYPICAL ROADWAY SECTION
LOOKING BACK ON STATIONING, NEAR MIDSPAN
SCALE: 1/4" = 1'-0"


GENERAL NOTES

1. ALL MATERIALS AND WORK SHALL BE IN ACCORDANCE WITH THE REQUIREMENTS OF THE STANDARD SPECIFICATIONS FOR CONSTRUCTION OF HIGHWAYS, 1987 EDITION, STANDARD SPECIFICATION FOR ROAD, BRIDGE, AND MUNICIPAL CONSTRUCTION, DATED 1984.
2. THE CURBS FOR THE WORKING ARE DESIGNED FOR ASPHALT HS-25 LIVE LOAD PLACED AT TWO FEET FROM THE CURB LINE AND ASSUMING SIMPLE SPAN DISTRIBUTION, AND CHECKED FOR THE CONDITION OF NO SIDEWALK AND USING THE APPROPRIATE ASPHALT DISTRIBUTION FACTOR. THE CURBS ARE DESIGNED BY A COMBINATION OF WORKING STRESS AND LOAD FACTOR METHODS.
3. THE DESIGN OF ALL ELEMENTS HAS BEEN PERFORMED IN ACCORDANCE WITH "ASHTO STANDARD SPECIFICATIONS FOR HIGHWAY BRIDGES, 1992", WITH ALL INTERIMS THROUGH 1994.
4. ALL SUBSTRUCTURE CONCRETE SHALL BE CLASS-5000 CONCRETE. THE DECK SLAB, SIDEWALKS AND BARRIER SHALL BE CLASS-5000 CONCRETE. THE CURB SHALL BE CLASS-5000 CONCRETE. ALL CLASS-5000, 5000 AND 5000LS CONCRETE SHALL HAVE 8% AIR ENTRAINMENT. THE PRESTRESSED ORDER CONCRETE SHALL HAVE A STRENGTH OF 8500 PSI AT 28 DAYS.
5. TO HELP ASSURE COMPATIBILITY WITH THE EXISTING STRUCTURE, ALL SUBSTRUCTURES AND ALL NEW SUBSTRUCTURES SHALL BE PERFORMED BY THE CONTRACTOR, IN ADDITION THE CHAMBER OF THE NEW GIRDERS SHALL BE CLOSELY MONITORED AND CONTROLLED TO ASSURE PROFILE COMPATIBILITY WITH THE EXISTING DECK ELEVATIONS.

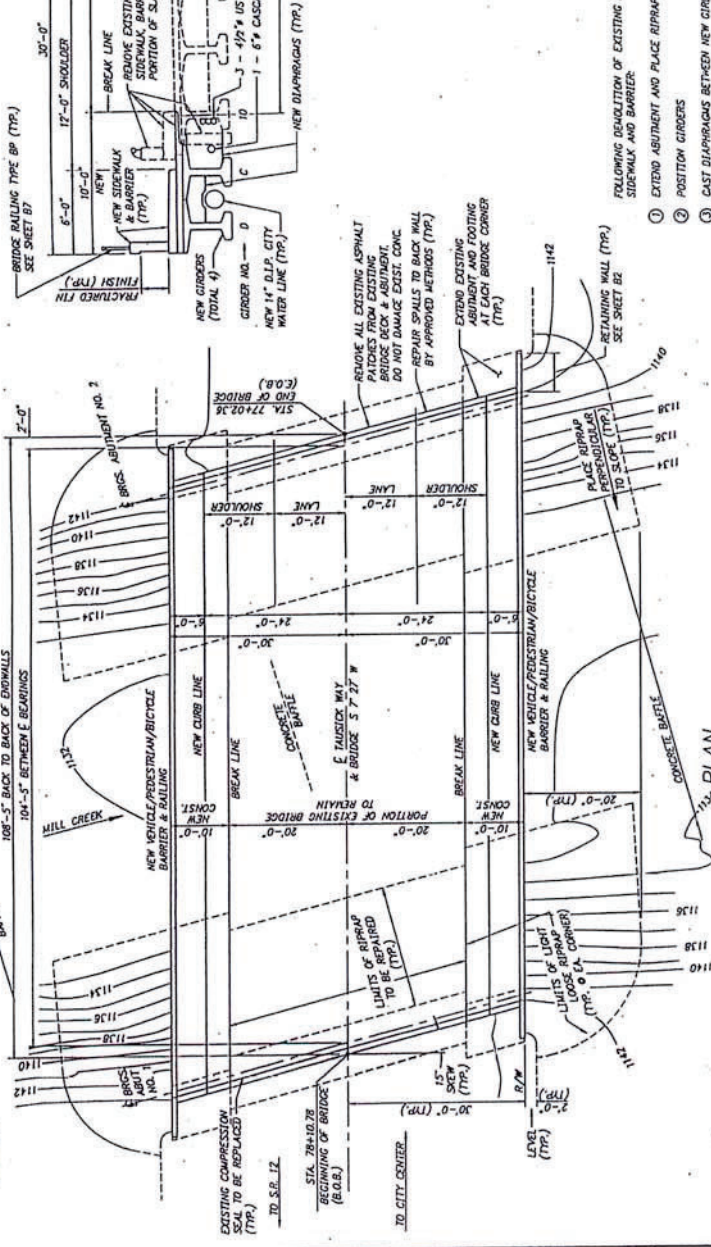


PLAN
SCALE: 1" = 10'

1. FOLLOWING DEMOLITION OF EXISTING DECK, SIDEWALK AND BARRIER
2. EXTEND ABUTMENT AND PLACE RIPRAP
3. POSITION GIRDERS
4. CAST DIAPHRAGMS BETWEEN NEW GIRDERS ONLY
5. CAST ROADWAY SLAB
6. CAST SIDEWALK AND BARRIER
7. CAST CLOSURE POUR
8. CAST DIAPHRAGMS BETWEEN NEW AND EXISTING GIRDERS (CONCRETE) 1/2-SAME CONCRETE AND FINISH FLUSH W/S LAB
9. INSTALL D.I.P. WATER LINE, BRIDGE RAILING & UTILITIES

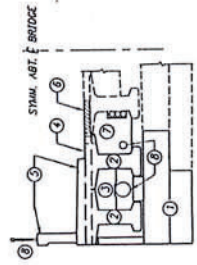

CONSTRUCTION SEQUENCE
N.T.S.

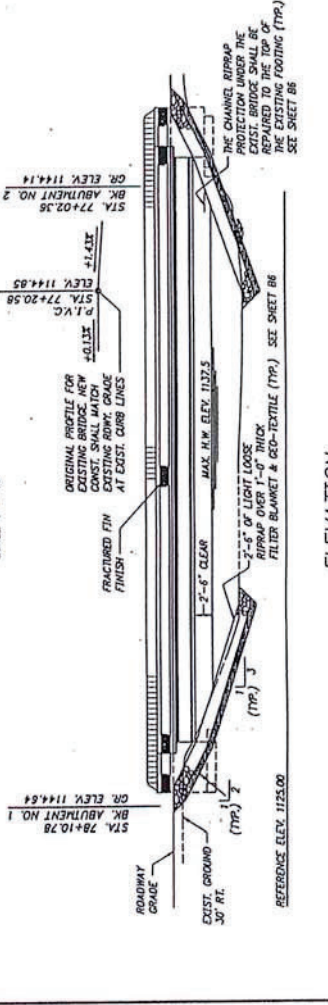

ELEVATION
SCALE: 1" = 10'



NO.	REVISION	BY	DATE	DESIGNED	AS BUILT	T. WITKOWSKI	DATE
		DRAWN		CHECKED		B. FROES	
				APPROVED			

SCALE: 1/8" = 1'-0"

FILE NO. 99-01-08

GENERAL PLAN




MILL CREEK BRIDGE

ALDER/JAUSICK/AIRPORT ROAD - TIB RECONSTRUCTION

ARVID GRANT ASSOCIATES CONSULTING ENGINEERS 6210 14TH, WASHINGTON, WA 98148

FILE NO. 99-01-08 & 0123 TIB, 2/10/00, 9/19/99

REGION NO.	STATE	FEDERAL AID PROJECT NUMBER	SHEET NO.	TOTAL SHEETS
16	WASH.	STPF-720000D	32	80

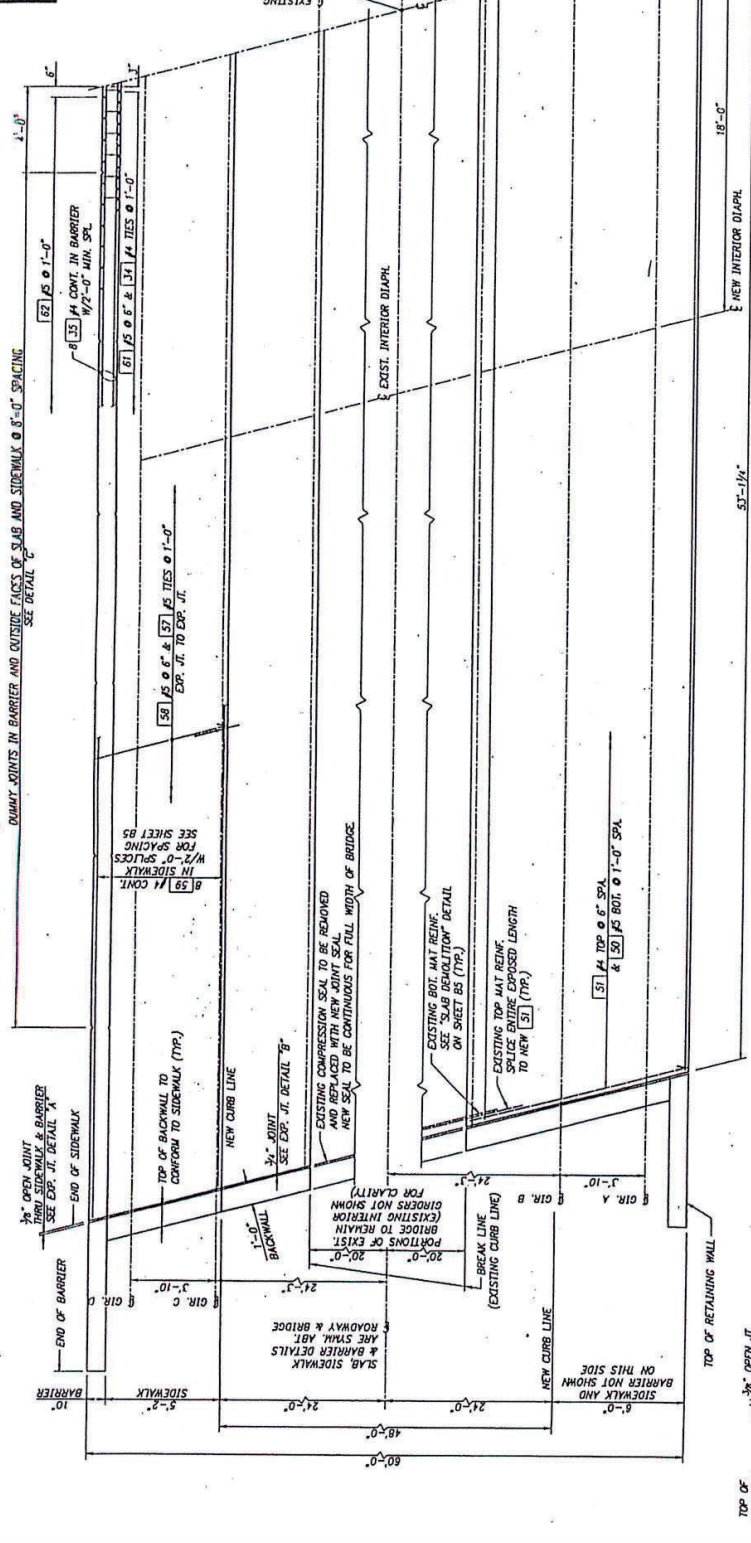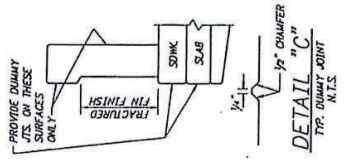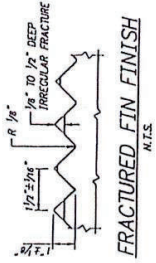


NOTE: SET SCREDS FOR A TOTAL OF 2.03 INCHES GAUGER ABOVE GRADE AT CENTER SPAN.

HALF PLAN FRAMING, ROADWAY SLAB, SIDEWALK & BARRIER

COMPRESSION SEAL TABLE


D. S. BROWN	WATSON ESHMAN	ELASTOMER	STRUCTURAL ACCESSORIES
SEAL	SEAL	SEAL	SEAL
CV-2000	WA-200	X-2000	SH-2000
2	2	2	2

* TESTING SHALL BE PER ASTM D-230 PRIOR TO USE.

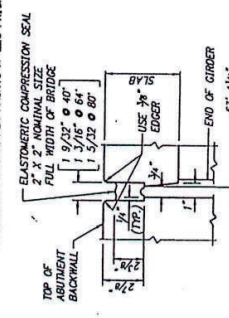

EXPANSION JT. DETAIL "B"

SCALE: 3" = 1'-0"

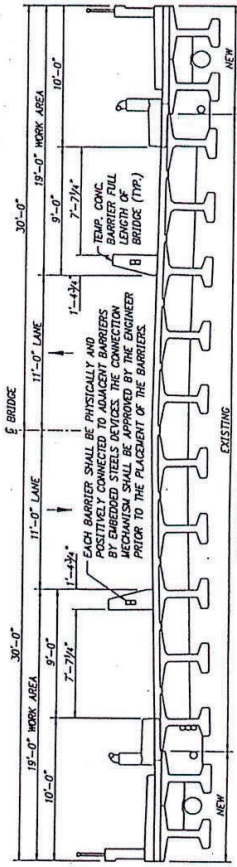

TRAFFIC CONTROL PLAN

SCALE: 3/4" = 1'-0"



DESIGNED BY	DATE	AS BUILT	DATE
DRAWN BY	AS NOTED	AS NOTED	AS NOTED
CHECKED BY	NO. REVISIONS	SCALE	NO. VERT.
APPROVED BY	D.B. GREEN	FILE NO.	

AGGREGATE

ARVID GRANT ASSOCIATES CONSULTING ENGINEERS 601 14TH ST. SE, SUITE 200, WASHINGTON, D.C. 20003

FILE NO. 09/09/1758 & 1713 P.C. CIVIL/ENR/SHEET-1


AGGREGATE

CITY OF WALLA WALLA PUBLIC WORKS / ENGINEERING WALLA WALLA, WASHINGTON 99142

ALDER/TAUSICK/AIRPORT ROAD - TIB RECONSTRUCTION MILL CREEK BRIDGE 5-1-95

ROADWAY SLAB, SIDEWALK & BARRIER PLAN

84 of 8

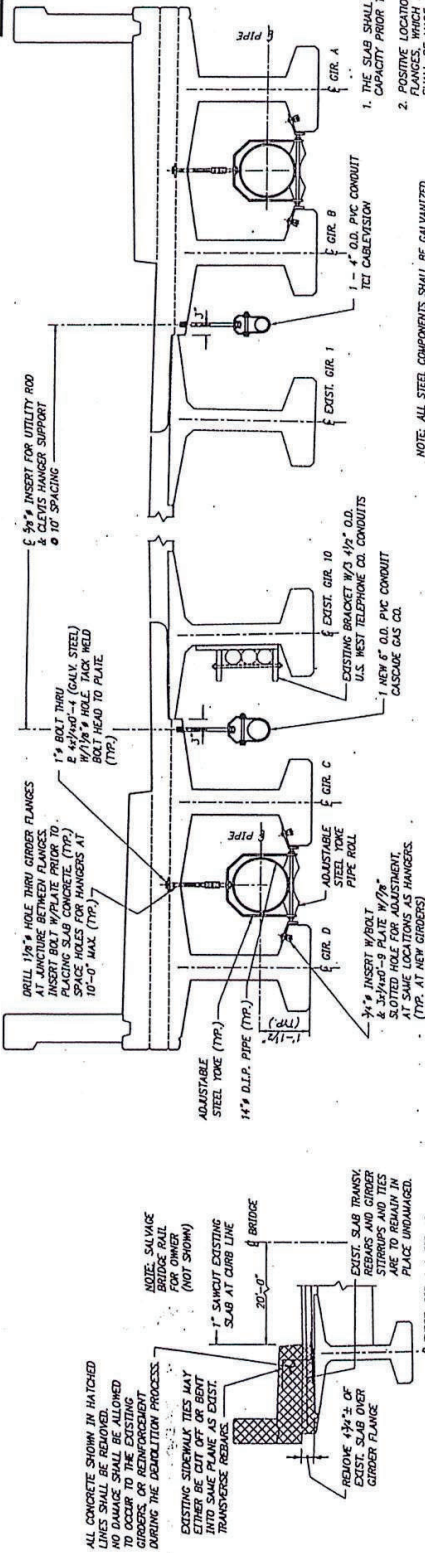

- NOTES**
1. THE SLAB SHALL HAVE OBTAINED 75% OF ITS 28 DAY STRENGTH CAPACITY PRIOR TO PLACEMENT OF ANY ADDITIONAL LOADS.
 2. POSITIVE LOCATION OF REINFORCEMENT IN EXISTING GIRDERS FLANGES, WHICH MAY INTERFERE WITH FIELD DRILLED HOLES, SHALL BE MADE. EVERY EFFORT SHALL BE MADE TO MISS THE EXISTING REINFORCEMENT IN THE DRILLING OPERATIONS.
 3. CLOSURE POUR SURFACE TREATMENT. SURFACE MUST BE CLEAN OF ALL DELETERIOUS MATERIAL AND CONTAIN NO SPALLING OR WEAKENING OF CONCRETE. REMOVE ALL LOOSE MATERIAL. REINFORCEMENT SHALL BE PLACED AT THE TIME OF PLACING CLASS-SUBSOLS CONCRETE. THE SURFACE MUST BE DAMP (SATURATED SURFACE DRY) BUT MUST NOT BE ANY STANDING WATER, AND CONTAIN NO MATERIAL THAT COULD ADVERSELY AFFECT THE BOND BETWEEN NEW AND OLD CONCRETE.
 4. DRILLING FOR 5/8" BOLTS REQUIRE 7/8" HOLES. AT THE END OF DIAPHRAGMS IT IS PREFERRED THAT THE DIAPHRAGMS WILL INTERFERE WITH THE DRILLING - THIS IS ACCEPTABLE. HOWEVER, UNDER NO CIRCUMSTANCES SHALL THE STEEL REINFORCEMENT BE DAMAGED AT THE INTERIOR DIAPHRAGM LOCATIONS. THEREFORE, POSITIVE LOCATION OF ALL STEEL IS REQUIRED PRIOR TO DRILLING.

NOTE: ALL STEEL COMPONENTS SHALL BE GALVANIZED.

UTILITY SUPPORT DETAILS
 SCALE: 3/4" = 1'-0"


SLAB DEMOLITION

EXISTING SIDEWALK TIES MAY BE REMOVED. ALL CONCRETE SHOWN IN HATCHED LINES SHALL BE REMOVED. EXISTING REINFORCEMENT TO OCCUR TO THE EXISTING GIRDERS OR REINFORCEMENT DURING THE DEMOLITION PROCESS. EXISTING SIDEWALK TIES MAY BE CUT OFF OR BEIT LIFTED FROM EXIST. TRANSVERSE REBARAS.

REMOVE 3/4" OF EXIST. SLAB OVER GIRDER FLANGE.

NOTE: SAWCUT EXISTING SLAB AT CURB LINE.

REMOVE 3/4" OF EXIST. SLAB TRANS. REBARAS AND GIRDER STRIPAS AND TIES ARE TO REMAIN IN PLACE UNDAHAGED.

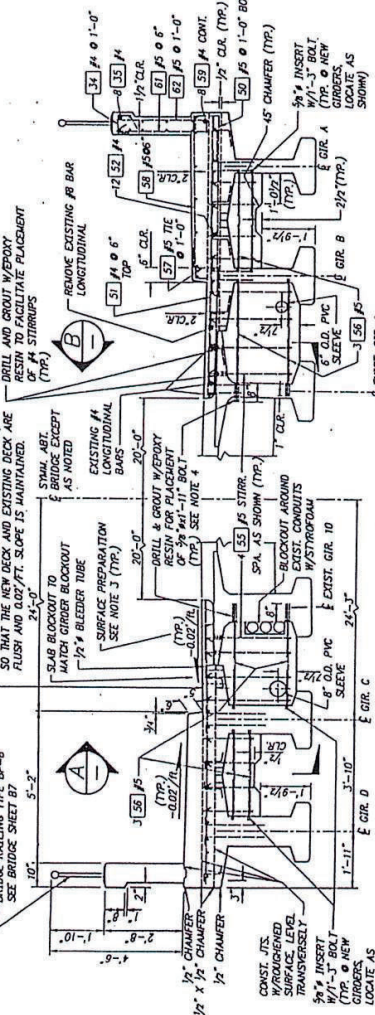

HALF SECTION AT END DIAPHRAGM
 NEAR ABUTMENT NO. 2; ABUTMENT NO. 1 SIMILAR.

HALF SECTION AT INTERIOR DIAPHRAGM
 FOR DETAILS NOT SHOWN SEE
 HALF SECTION AT END DIAPHRAGM

ROADWAY SECTION
 LOOKING BACK ON STATIONING
 SCALE: 3/4" = 1'-0"

REVISION	BY	DATE	REASON	AS BUILT	DATE

CITY OF WALLA WALLA
 PUBLIC WORKS / ENGINEERING
 WALLA WALLA, WASHINGTON 99152

AGA

ARVID GRANT ASSOCIATES
 CONSULTING ENGINEERS
 02-TUPLA, WASHINGTON
 FILE NO. 07/07/1998 @ 7:24 PM. CIVILWORKS-SHEET-3

ALDER/TAUSICK/AIRPORT ROAD - TIB RECONSTRUCTION
 MILL CREEK BRIDGE
 SECTIONS
 85 OF 85
 PNC



SHT 35 of 80

NOTES

PIPE RAILING, PIPE RAILING SPLICES, COVER PLATES AND BOTTOM EXTRUDED CHANNELS SHALL BE BENT TO THE HORIZONTAL CURVE WHERE THE RADIUS OF CURVATURE IS LESS THAN 200 FEET.

SHOP DRAWINGS OF RAILING SHALL BE SUBMITTED FOR APPROVAL SHOWING COMPLETE DIMENSIONS AND DETAILS OF FABRICATION INCLUDING THE ERECTION DIAGRAM. MATERIAL BEING USED SHALL BE DESCRIBED IN THE SHOP DRAWINGS.

ALL ALUMINUM PARTS SHALL BE GIVEN A BRONZ ANODIC COATING AT LEAST 0.0006" THICK, AND SHALL BE SEALED TO MEET THE REQUIREMENTS OF ASTM B 136 AND SHALL HAVE UNIFORM FINISH.


PIPE RAILING, PIPE RAILING SPLICES, COVER PLATES AND BOTTOM EXTRUDED CHANNELS MAY BE HEATED TO NOT MORE THAN 400°F FOR A PERIOD NOT TO EXCEED 30 MIN. TO FACILITATE FORMING OR BENDING.

CUTTING SHALL BE DONE BY SAWING OR MILLING AND ALL CUTS SHALL BE TRUE AND SMOOTH. FLAME CUTTING WILL NOT BE PERMITTED.

PIPE ROLLING, PIPE BALUSTERS, PIPE ROLLING SPLICES, COVER PLATES AND BOTTOM EXTRUDED CHANNELS SHALL BE ABSOLUTELY WRAPPED TO INSURE SURFACE PROTECTION DURING HANDLING AND TRANSPORTATION TO THE JOB SITE.



WELDING OF ALUMINUM SHALL BE IN ACCORDANCE WITH SECTION 5 OF THE LATEST AASHTO STANDARD SPECIFICATIONS FOR STRUCTURAL SUPPORTS FOR HIGHWAY SIGNS, LUMINAIRES AND TRAFFIC SIGNALS.

BALUSTER & BOLT SPACINGS SHOWN ARE MAXIMUM ALLOWABLE VARY AS NECESSARY ADJUSTMENT TO BRIDGE EXPANSION JOINTS.

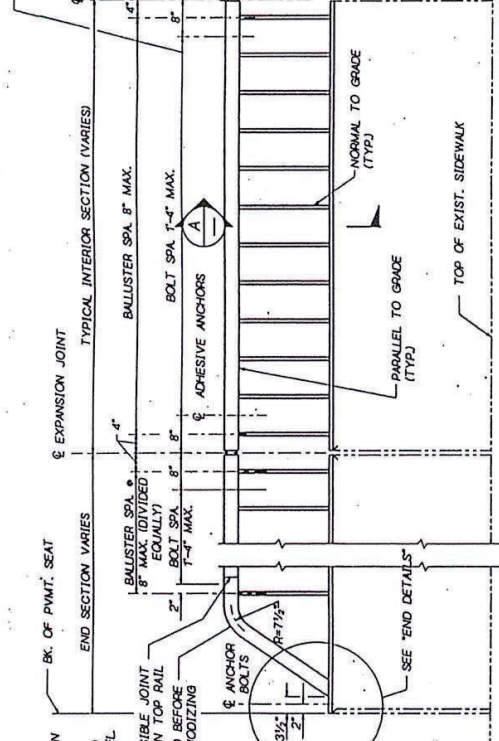


ELEVATION


BALUSTER AND THREE-BEAM GUARDRAIL ATTACHMENT DETAILS NOT SHOWN

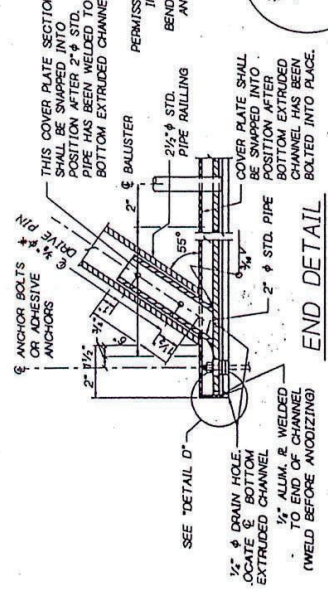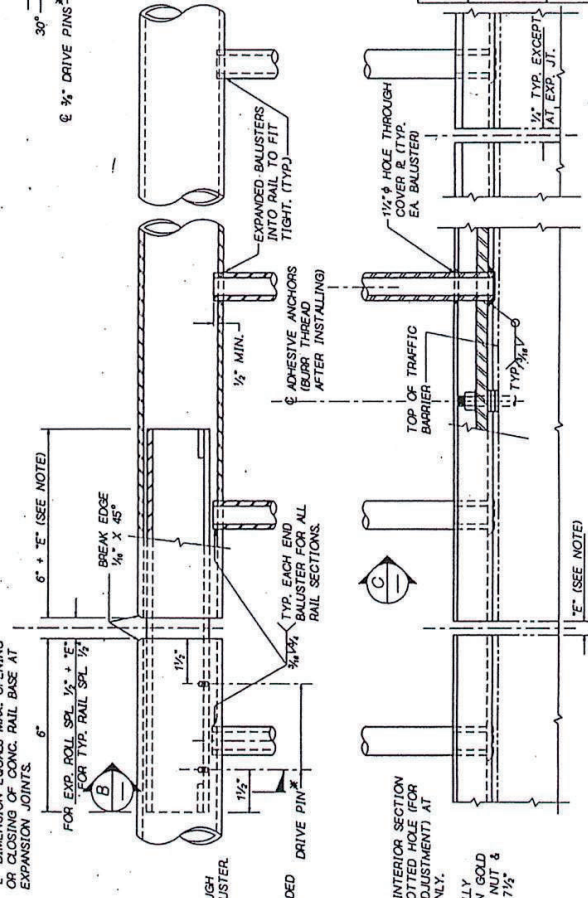


END DETAIL

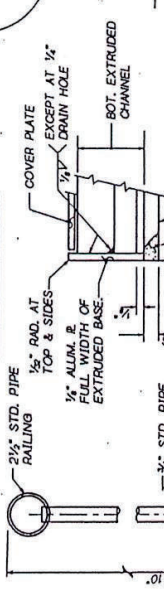

SECTION A

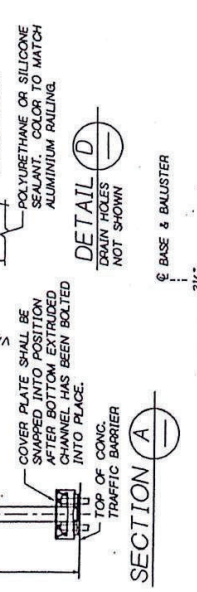

SECTION B

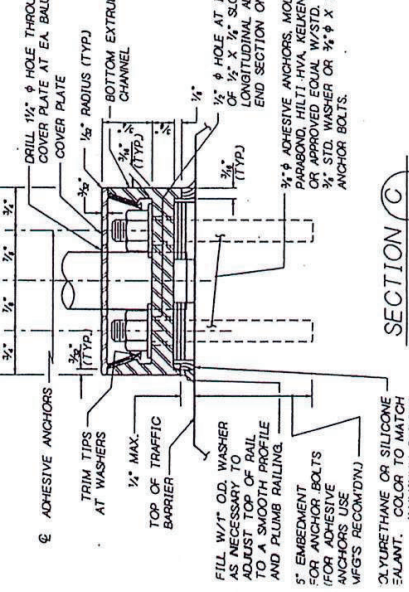

SECTION C



PART	MATERIAL SPECIFICATION
PIPES	ASTM B241 OR B249 ALLOY 6061-T6 OR 6066-T5 SCHEDULE 40 (STD. PIPE)
EXTRUDED CHANNELS & COVER PLATES	ASTM B221 ALLOY 6061-T6 OR 6065-T5
ANCHOR BOLTS, NUTS & WASHERS	AASHTO M164 (GALVANIZE IN ACCORDANCE WITH AASHTO SPECIFICATION M222)
PLATES	AASHTO M 183
DRIVE PINS	ASTM A-276 TYPE 300 STAINLESS STEEL

ALDER/TRAUSICK/AIRPORT ROAD
TIB RECONSTRUCTION
MILL CREEK BRIDGE S-1-92

ARVID GRANT ASSOCIATES
CONSULTING ENGINEERS

ACFA
CITY OF WALLA WALLA
PUBLIC WORKS / ENGINEERING

NO.	DATE	REV.	BY	CHK.
10				

10 WASH
JOB NUMBER